


T. 24 S. R. 30 & 31 E. W.M.

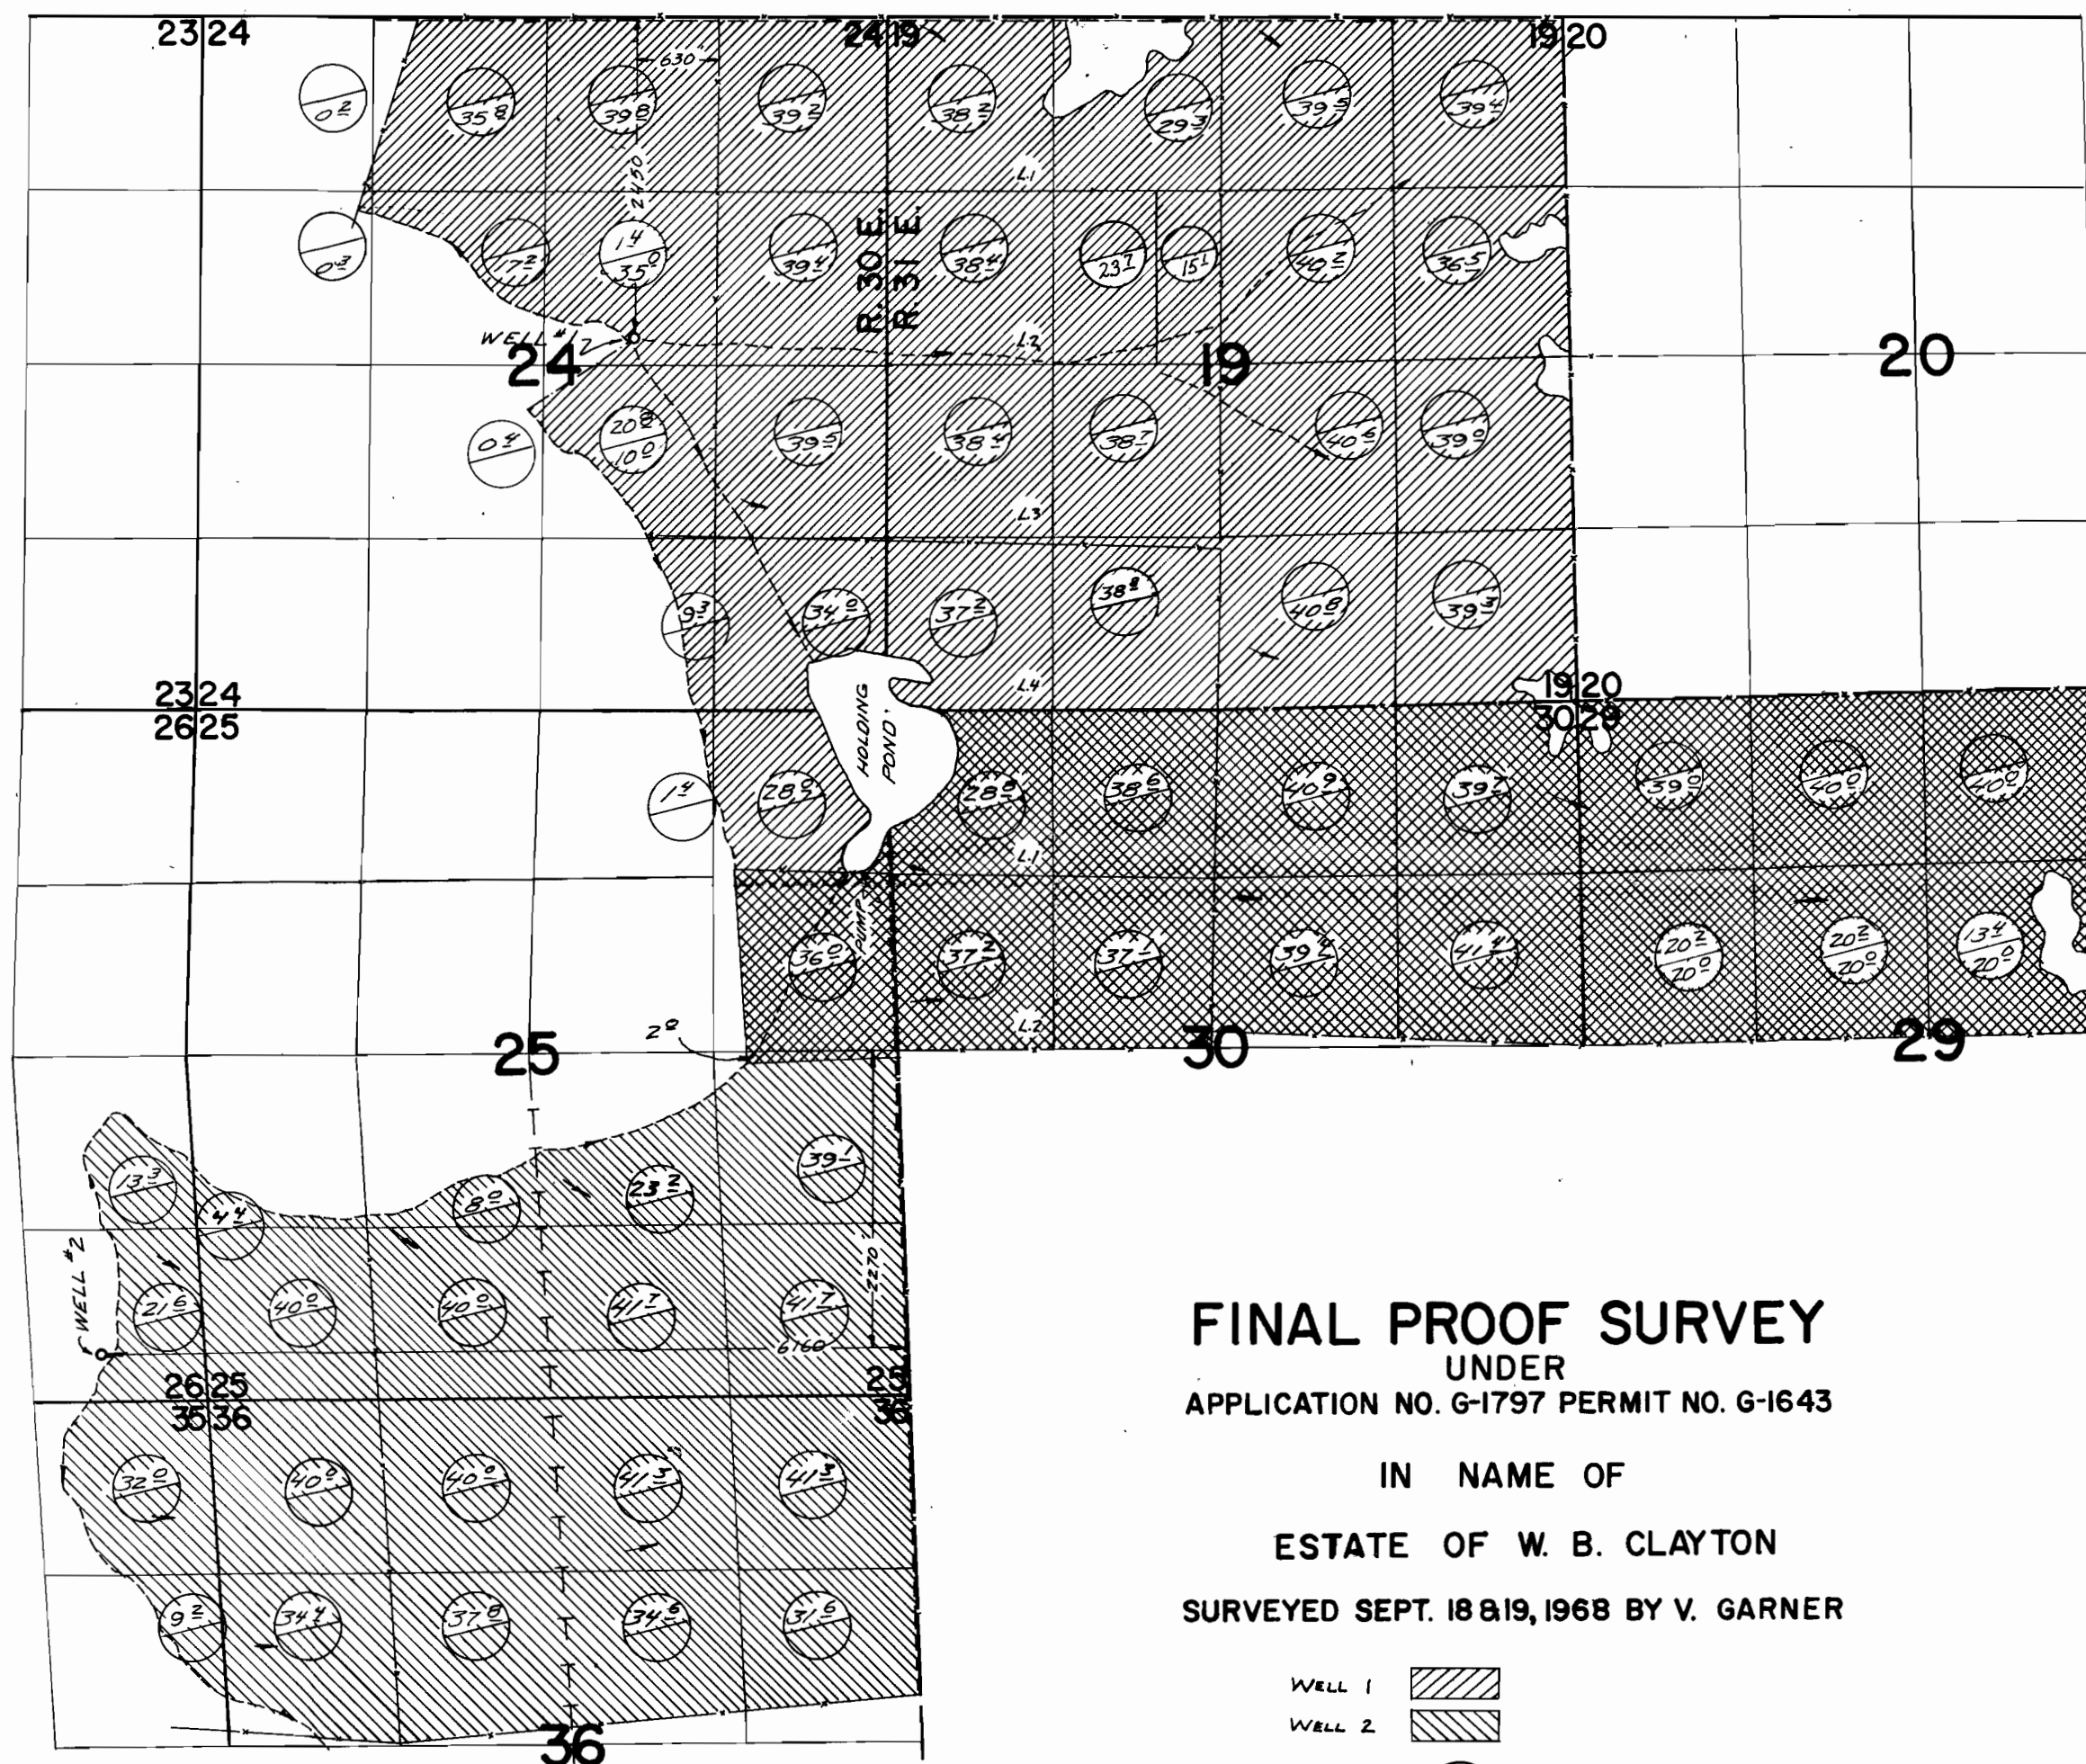

FINAL PROOF SURVEY

UNDER
APPLICATION NO. G-1797 PERMIT NO. G-1643

IN NAME OF
ESTATE OF W. B. CLAYTON
SURVEYED SEPT. 18 & 19, 1968 BY V. GARNER

WELL 1 
WELL 2 
PRIMARY 
SUPPLEMENTAL 