


T. 35 1/2S. R. 32 1/2E. W.M.

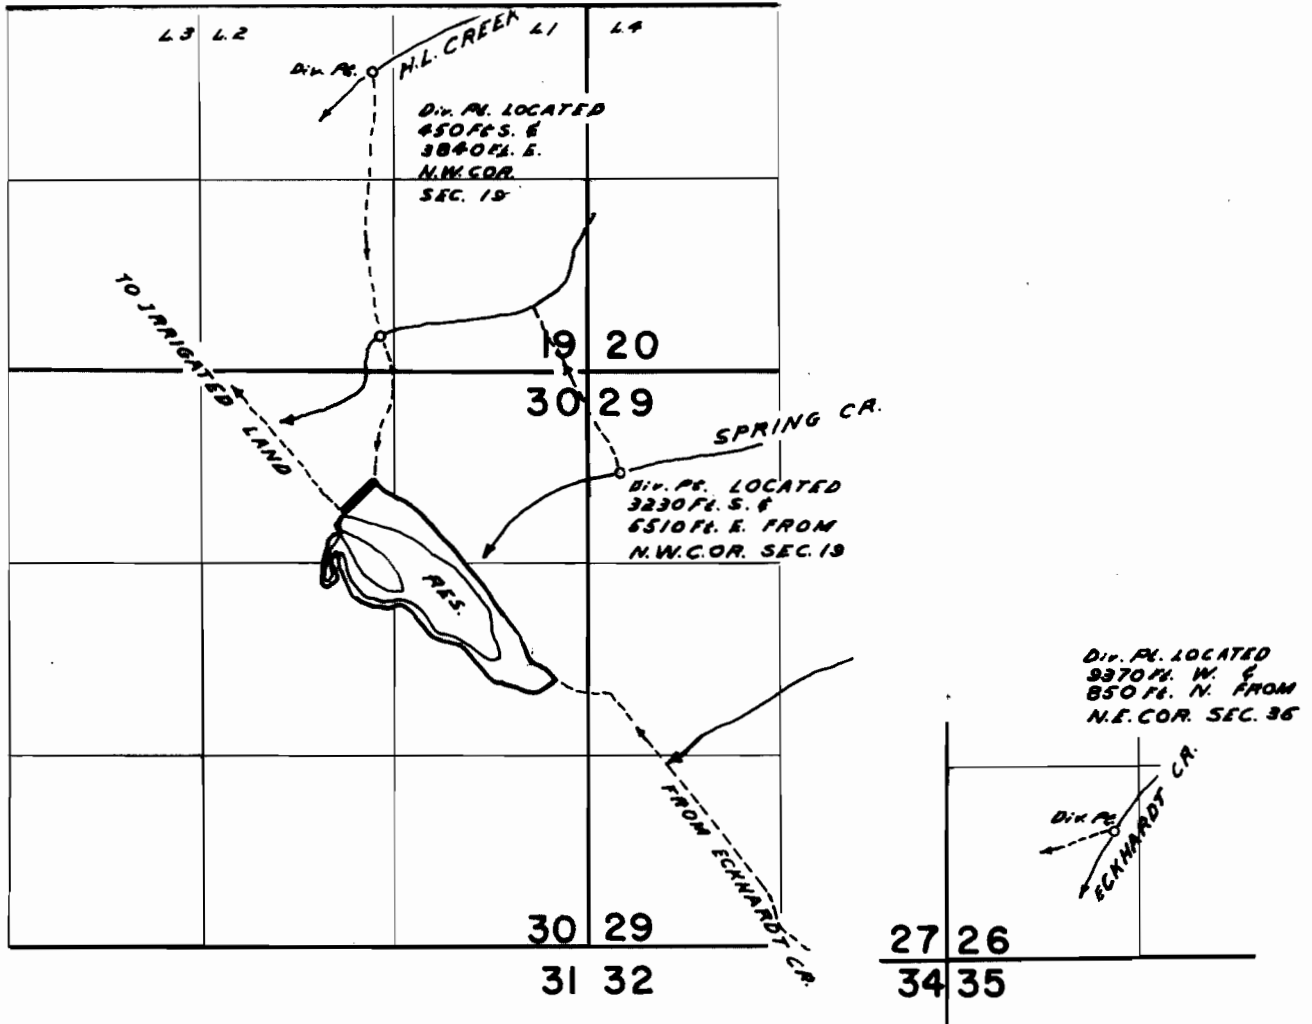

FINAL PROOF SURVEY
UNDER

Application No. R-18475 Permit No. R-776
IN NAME OF


ALLIED LAND & LIVESTOCK CO.

Surveyed AUG 22 23 1963, by T. LAUER
SEPT 22, 1965 by L. COLEBANK

[illegible]

1963-C 1965-V 324.

T 35 1/2 S R 32 1/2 E W M

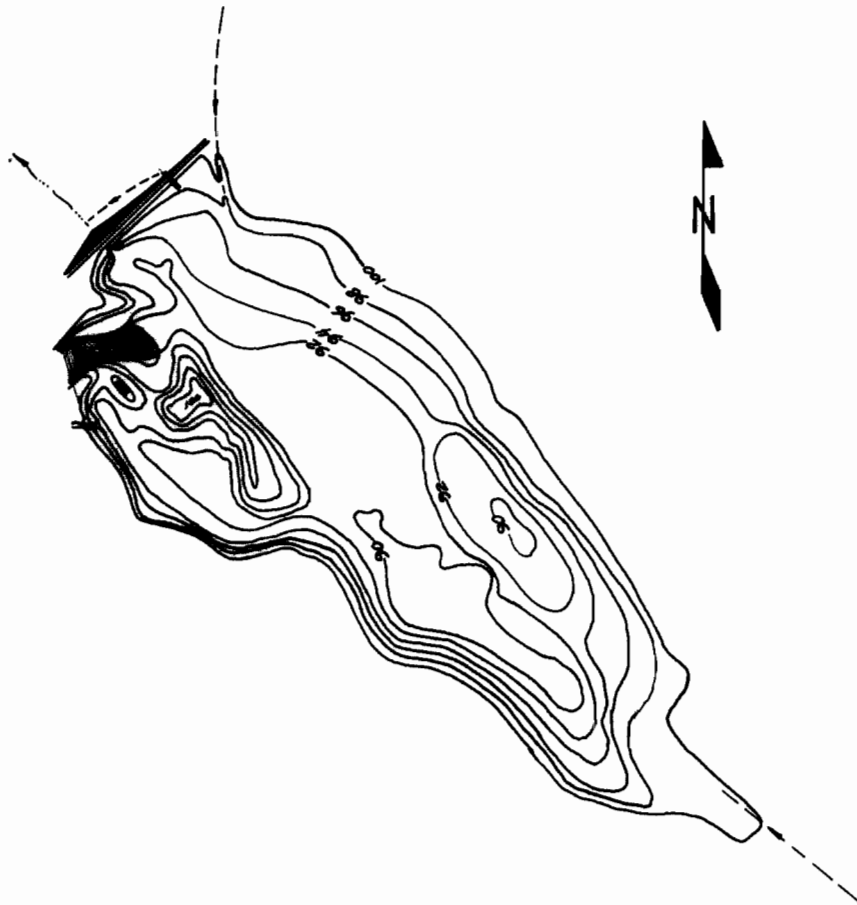

CAPACITY SURVEY OF H.L. RESERVOIR
LOCATED IN THE NE 1/4 OF SECTION 30

SCALE = 1" = 400'
CONTOUR INTERVAL = 2'

FINAL PROOF SURVEY
UNDER

Application No. *R-18475*. Permit No. *R-766*
IN NAME OF

ALLIED LAND and LIVESTOCK CO.

Surveyed *Aug 5*, 1968, by *V. Garner*