


T. 35 1/2 S. R. 32 & 32 1/2 E. W.M.

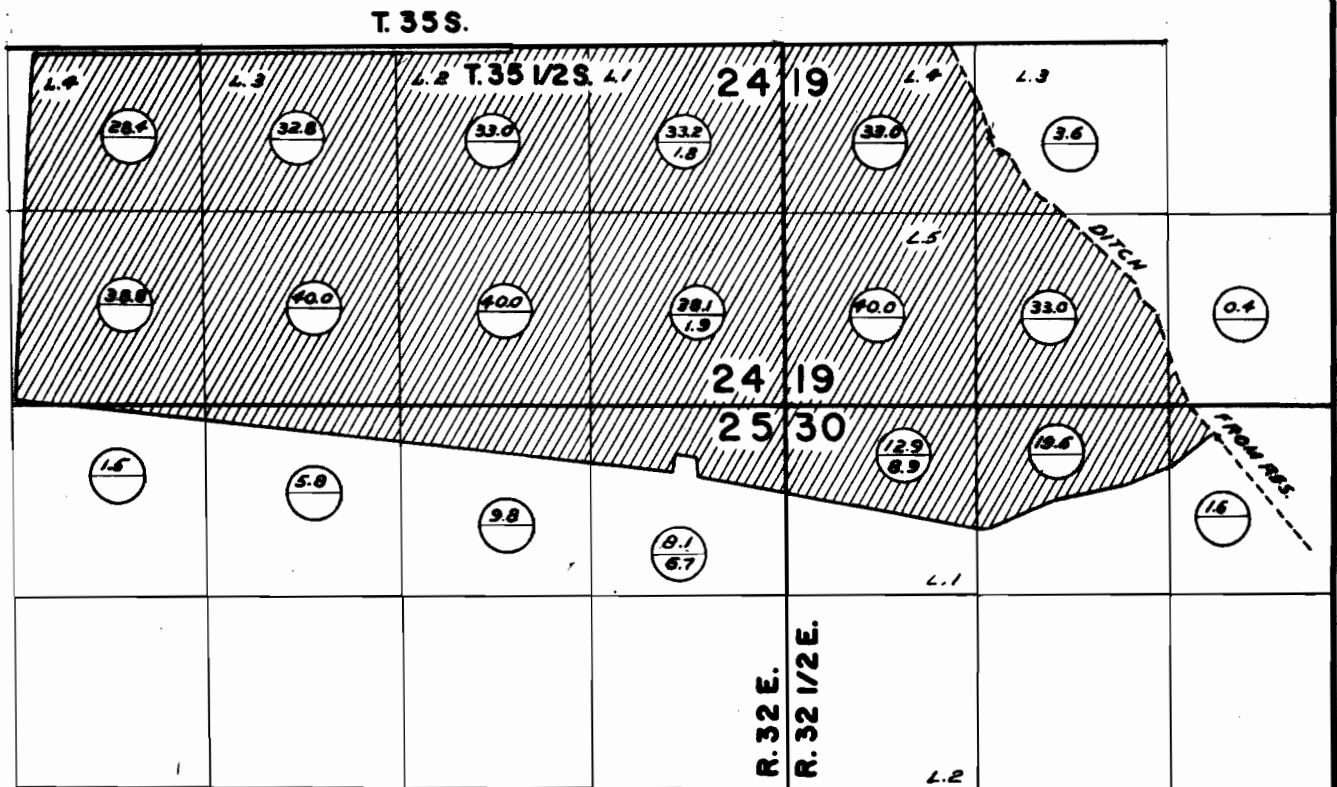

DESIGNATION FOR ACREAGE
S = SUPPLEMENTAL P = PRIMARY

FINAL PROOF SURVEY UNDER

Application No. 10476 Permit No. 15008
IN NAME OF

ALLIED LAND & LIVESTOCK CO.

Surveyed AUG 22, 23, 1963, by T. LAUER