


T. 37 & 38 S. R. 4 W. W.M.

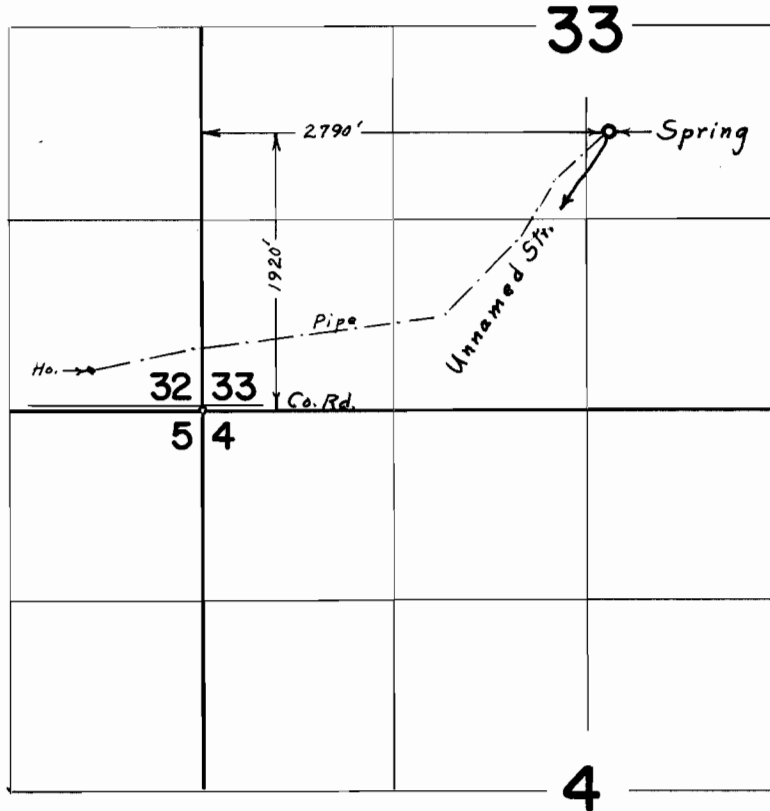

FINAL PROOF SURVEY
UNDER

Application No. 40997. Permit No. 30571.
IN NAME OF

HAZELLE HALLMARK

Surveyed June 11, 1969, by L. E. Gould.