


T. 39 S. R. 20 E. W.M.

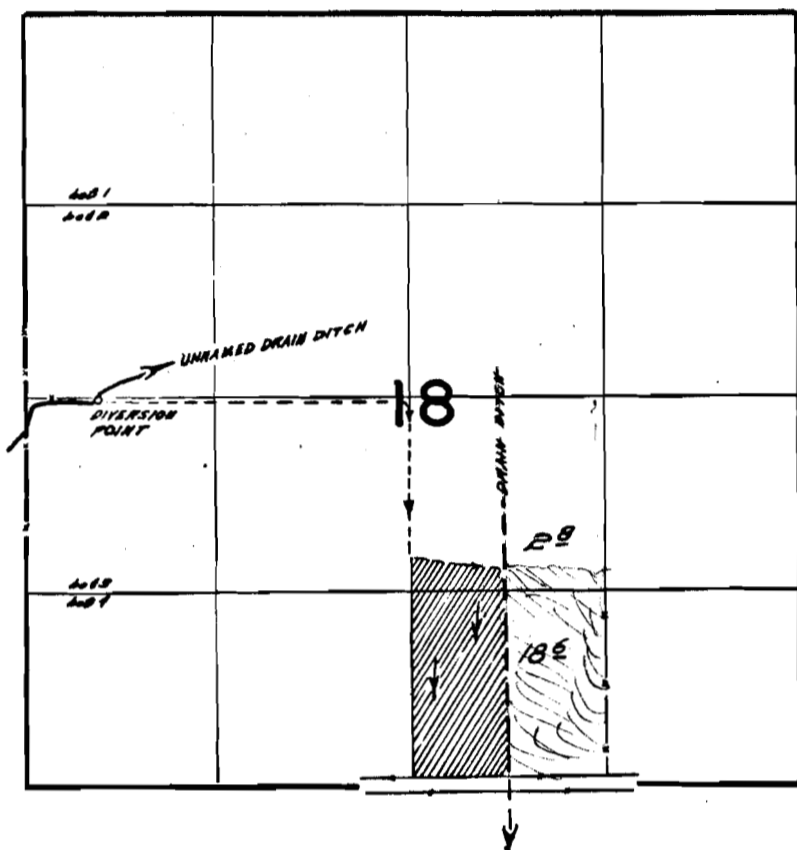

DIVERSION POINT LOCATED 10 P.S. & 180 P.E. FROM N.W. COR. SEC 18

FINAL PROOF SURVEY UNDER

Application No. 33839. Permit No. 27308.
IN NAME OF

R. H. RADFORD

Surveyed June 31 1968, by *M. G. Ruppert*

39-206 ✓