


T.19S.R.2W.W.M.

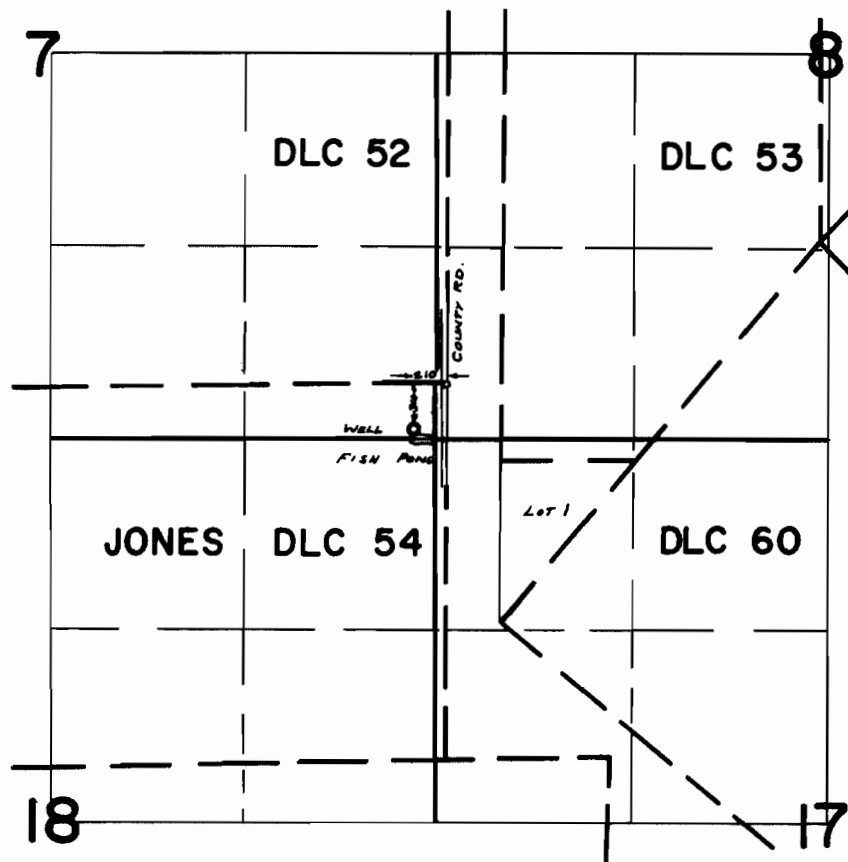

FINAL PROOF SURVEY
UNDER

Application No. *G-3705* Permit No. *G-3505*
IN NAME OF

HEINRICH H. WAECHTER

Surveyed *MAY 2, 1969*, by *W. RUPPERT*