


T.22S.R.3W.W.M.

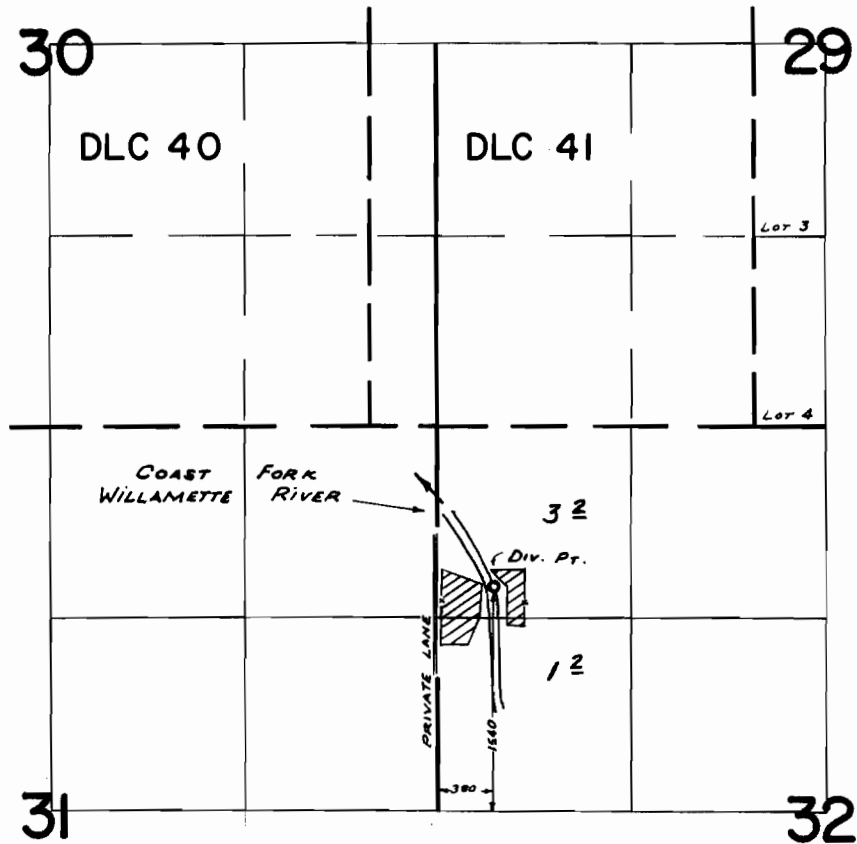

FINAL PROOF SURVEY
UNDER

Application No. 41849 Permit No. 31318
IN NAME OF

FRANK A. & ALMA R. GUISSINGER

Surveyed APR 29, 1969, by W. RUPPERT