


T.19S.R.1W.W.M.

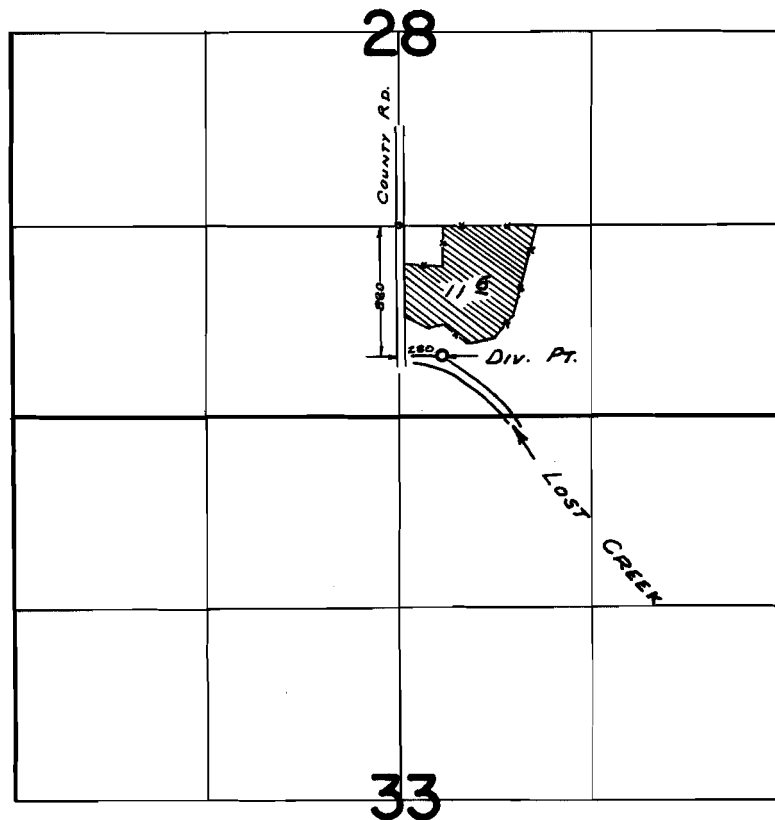

FINAL PROOF SURVEY
UNDER

Application No. 43594 Permit No. 32597
IN NAME OF

HENRY BAMER

Surveyed MAY 2, 1969, by W. RUPPERT