


T. 15 S. R. 4 W. W.M.

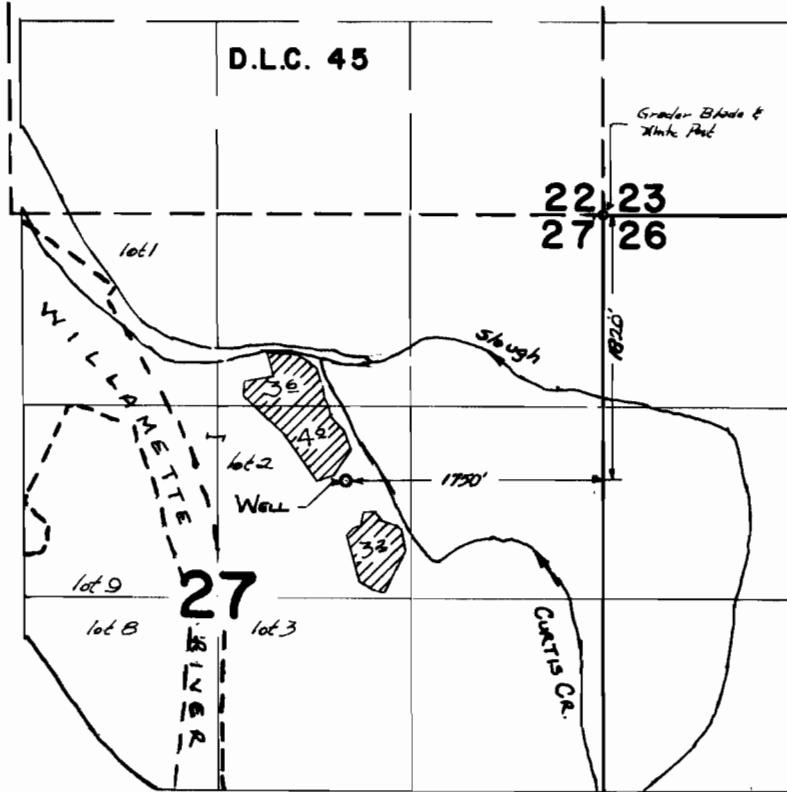

FINAL PROOF SURVEY
UNDER

Application No. G 2578 Permit No. G 2391
IN NAME OF

ESTATE OF OTTO STRODA

Surveyed 18 SEPT 1969, by W. J. RUPPERT