


T.11S.R.2W.W.M.

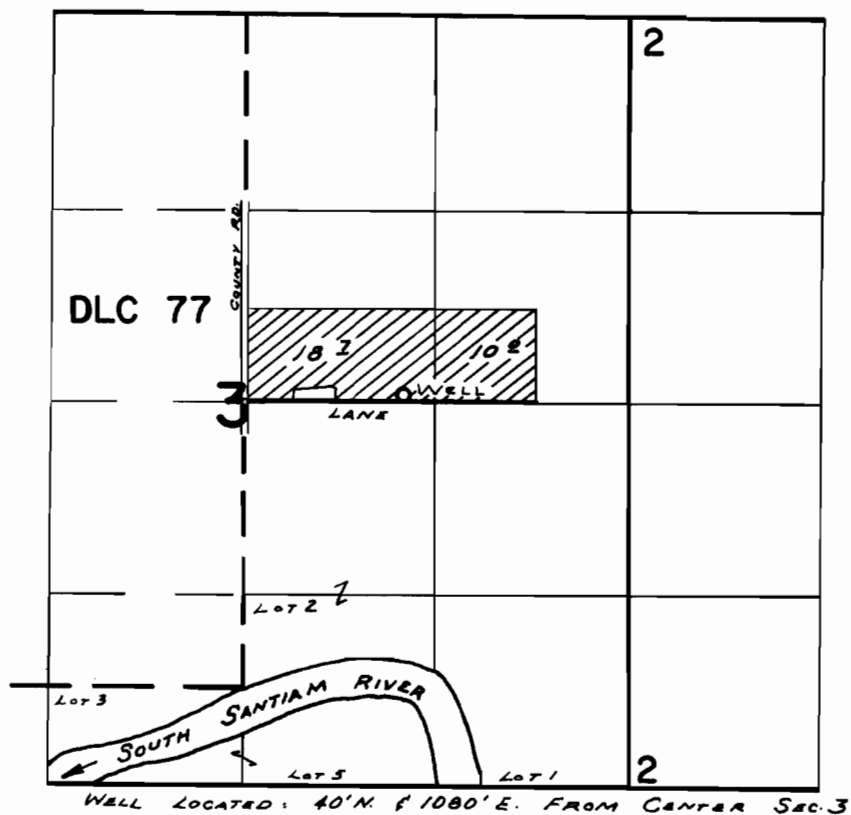

FINAL PROOF SURVEY
UNDER

Application No. G-3185 Permit No. G-2991
IN NAME OF

ROMAN J. & FLORENCE MEYER

Surveyed MAY 29, 1962, by W. RUPPERT