


T.I.S.R.I.E.W.M.

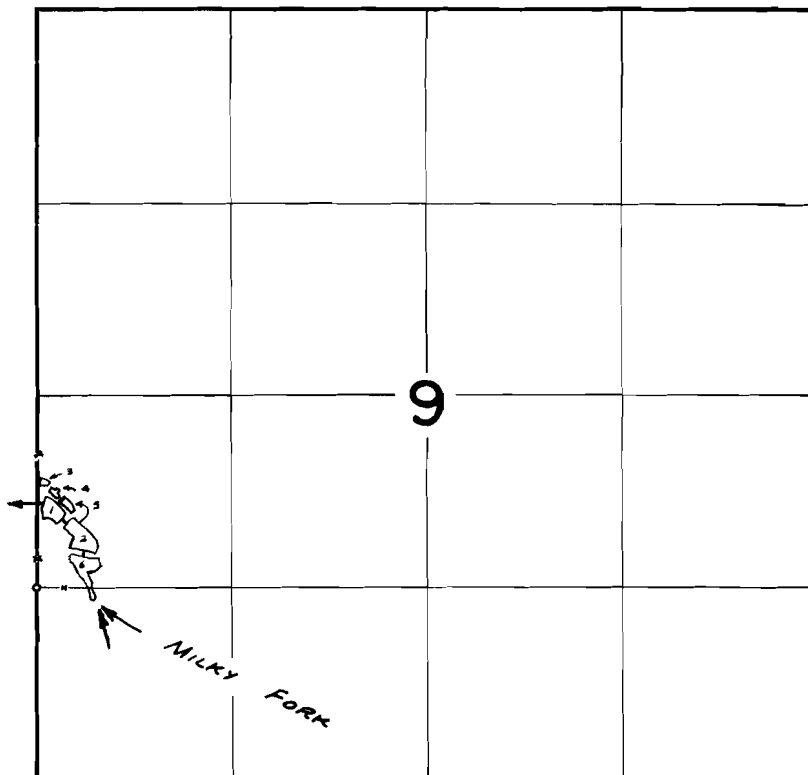

DIV. PTS. LOCATED: 220' N. 6320' E.; 440' N. 6200' E.; 580' N. 650' E.;
ALL FROM S.W. COR. NW 1/4 SW 1/4 SEC. 9

FINAL PROOF SURVEY
UNDER

42348 31874
Application No. R-42777 Permit No. R-4850
IN NAME OF

H. A. LARSEN

Surveyed APR. 22, 1969, by W. RUPPERT