


T. 13 S. R. 2 E. W. M.

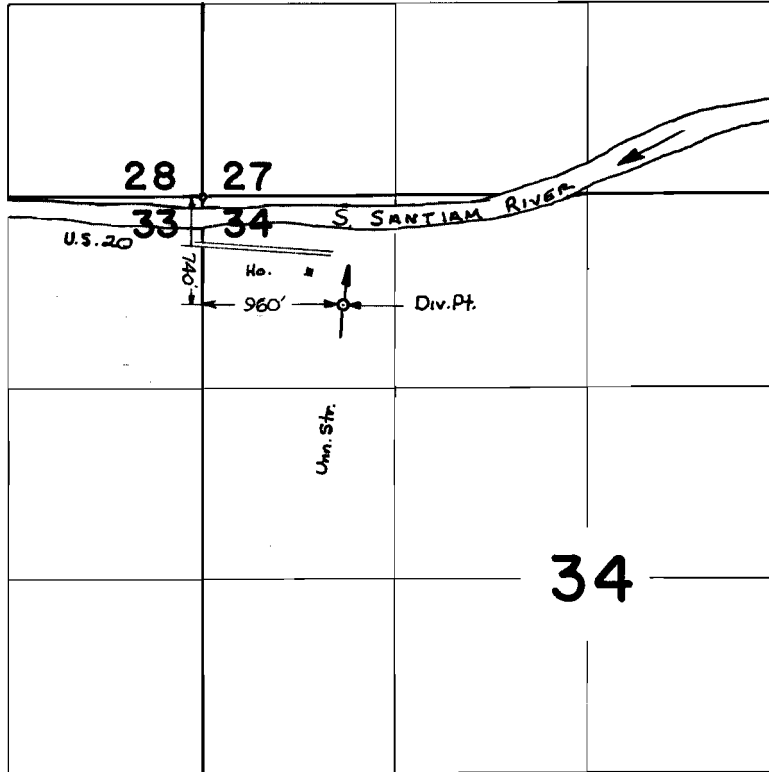

FINAL PROOF SURVEY
UNDER

Application No. 40031... Permit No. 29814....
IN NAME OF

WILLIS G. & MAXINE V. RICE

Surveyed 16 SEPT 1969, by W. J. RUPPERT