


T. 13 S. R. 1 W. W. M.

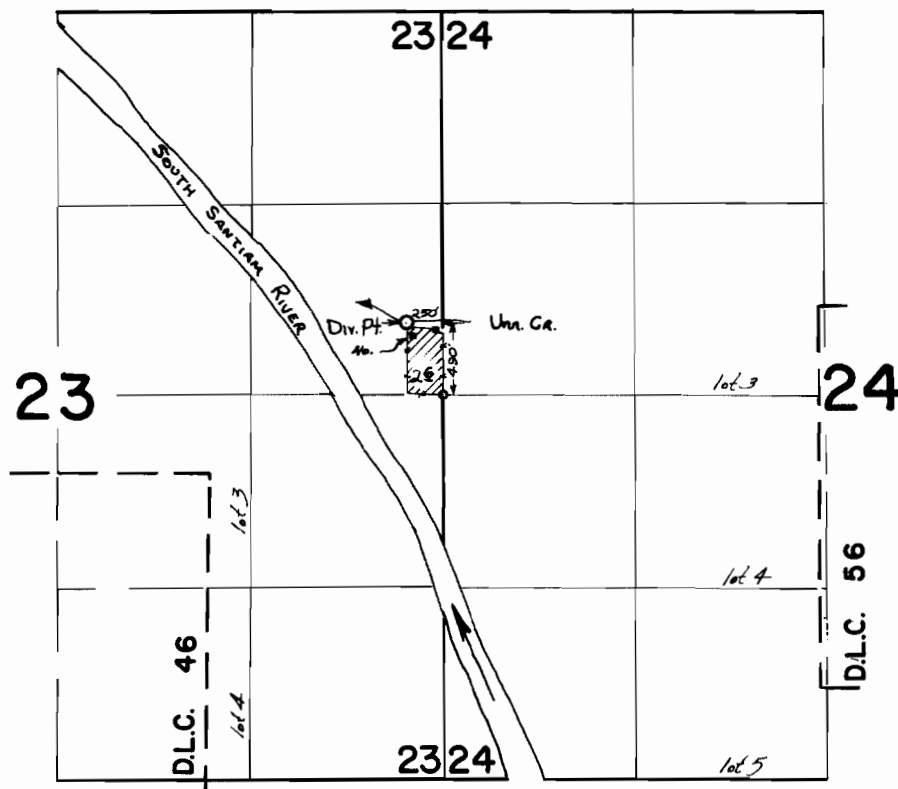

FINAL PROOF SURVEY
UNDER

Application No. 41239..... Permit No. 30755.....
IN NAME OF

JACK J. & MILDRED M. CROMWELL

Surveyed 3 SEPT. 1969, by W. J. RUPPERT