


T. 12 S. R. 1 & 2 W. W.M.

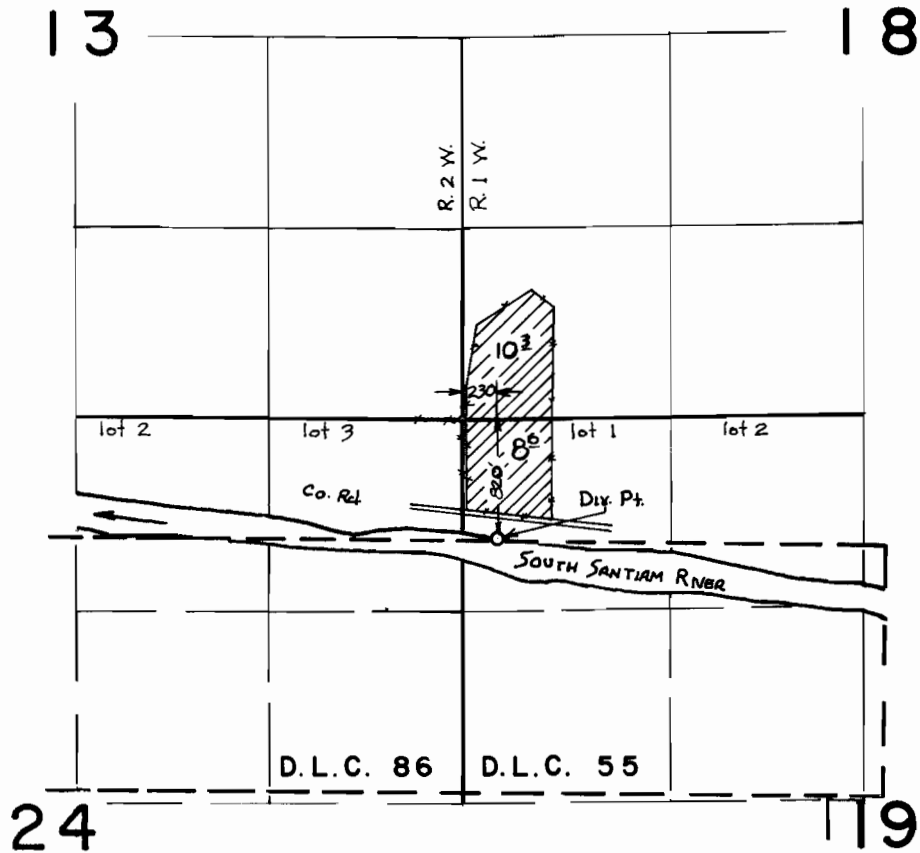

**FINAL PROOF SURVEY**  
UNDER

Application No. 42818 Permit No. 31696  
IN NAME OF

J.A., MARY J., J.A.II, & KAREN L. SANDERS

Surveyed 31 JULY 1969, by W. J. RUPPERT