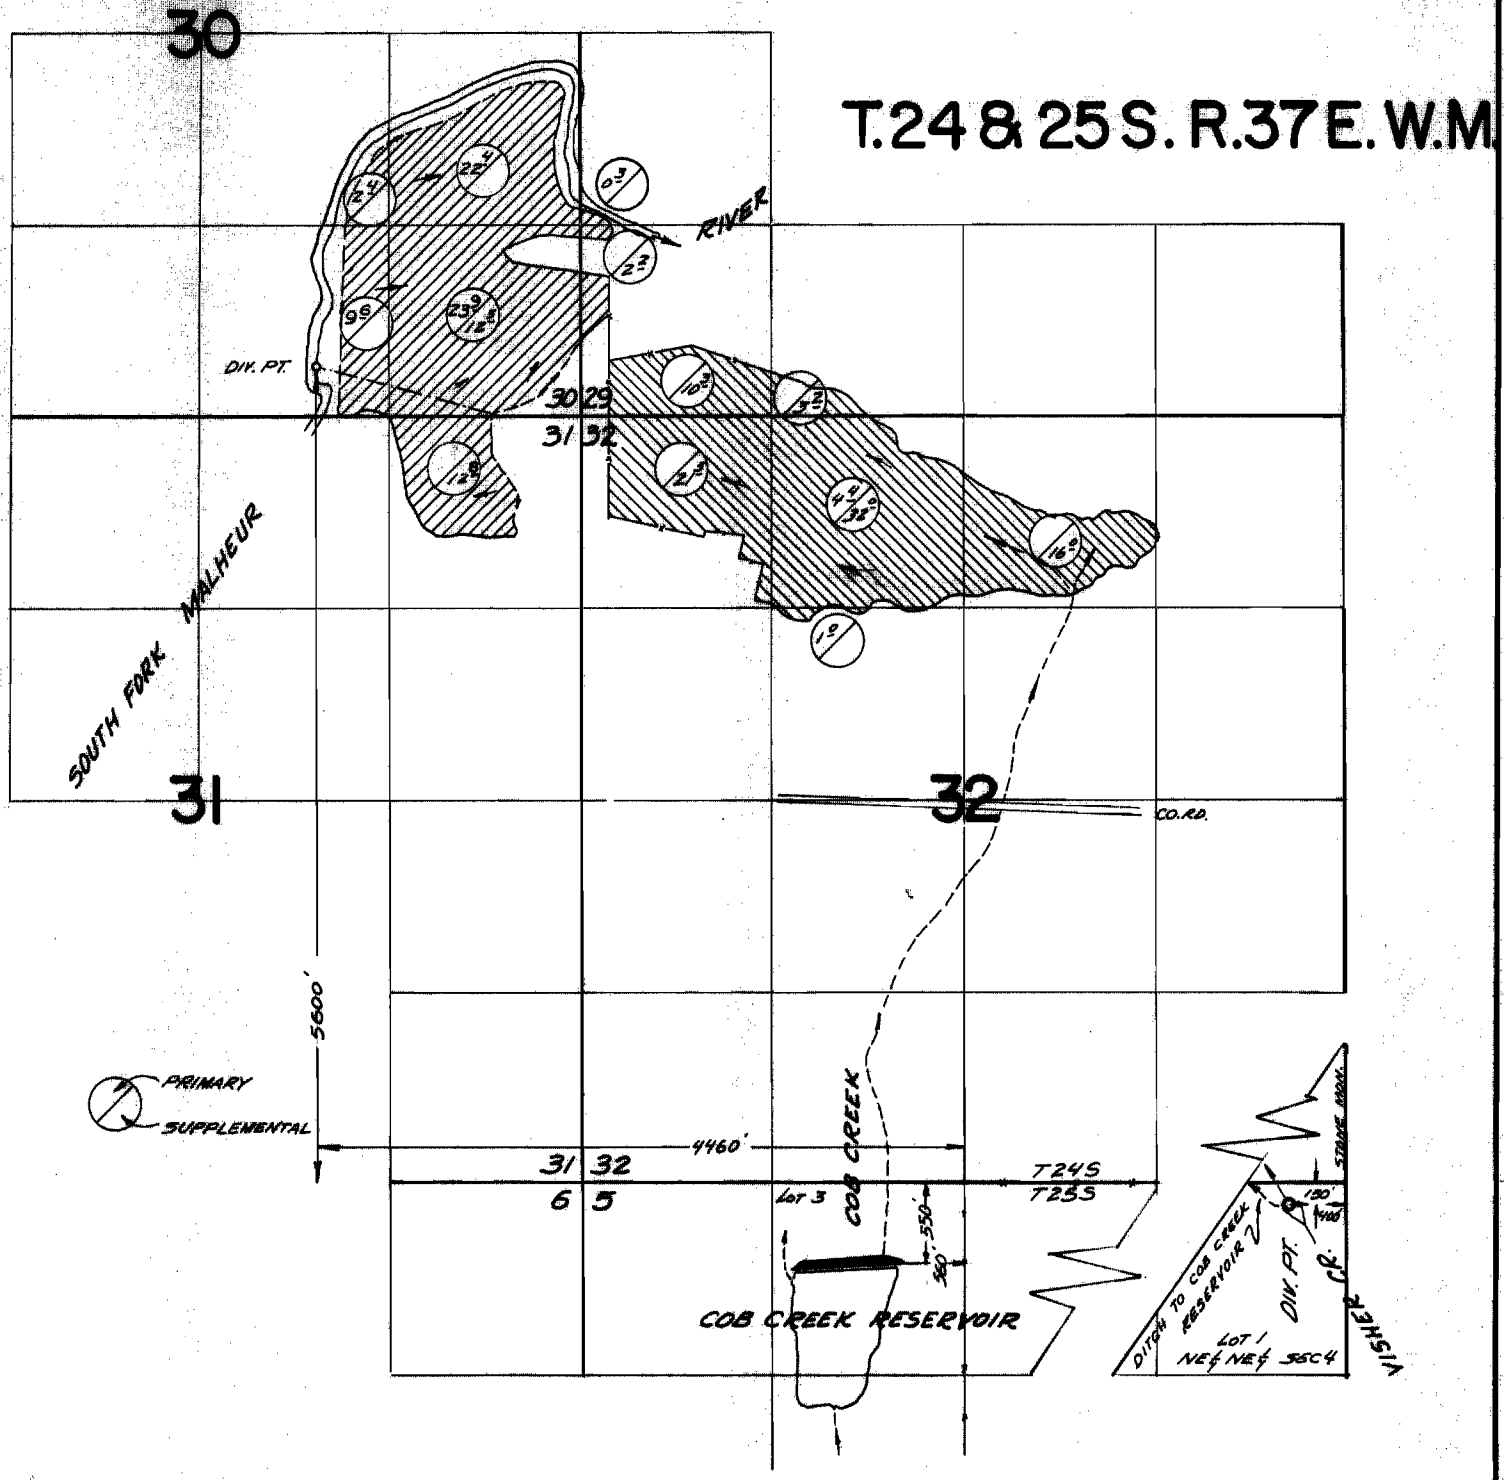

FINAL PROOF SURVEY

UNDER

35210 R-36594 — 27921 R-2863

Application No. 36595 Permit No. 27922

IN NAME OF

JAMES M. McEWEN

Surveyed Oct. 23 1968, by V. Garner

1968-F