


T.8 S. R.4 W. W.M.

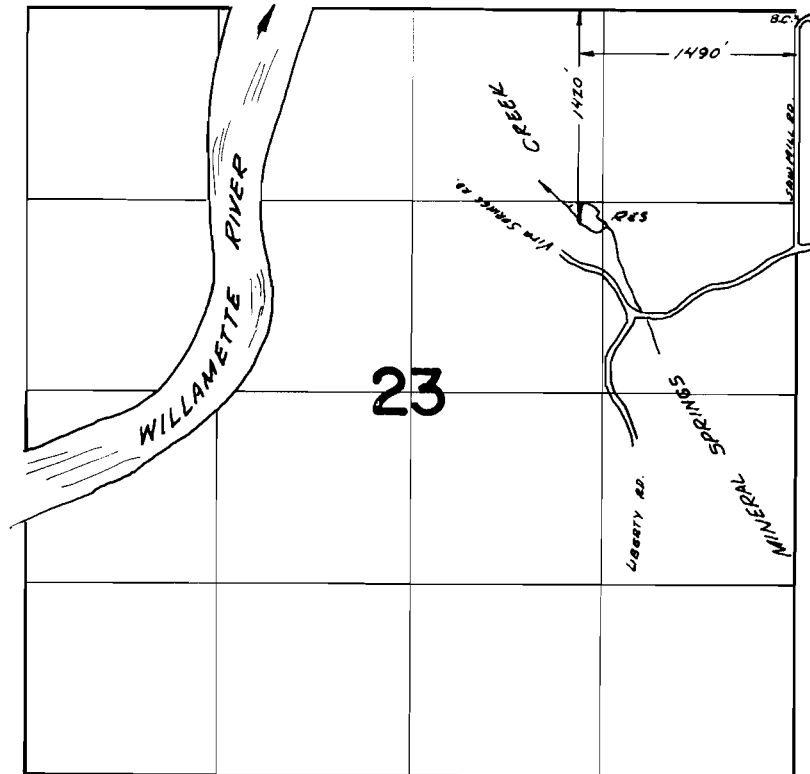

**FINAL PROOF SURVEY**  
UNDER

Application No. *R42669* 42670 Permit No. *R4844* 31888  
IN NAME OF

*N. H. DICKEY*

Surveyed *April 26 1968*, by *V. GARNER*