


T.9S. R.2W. W.M.

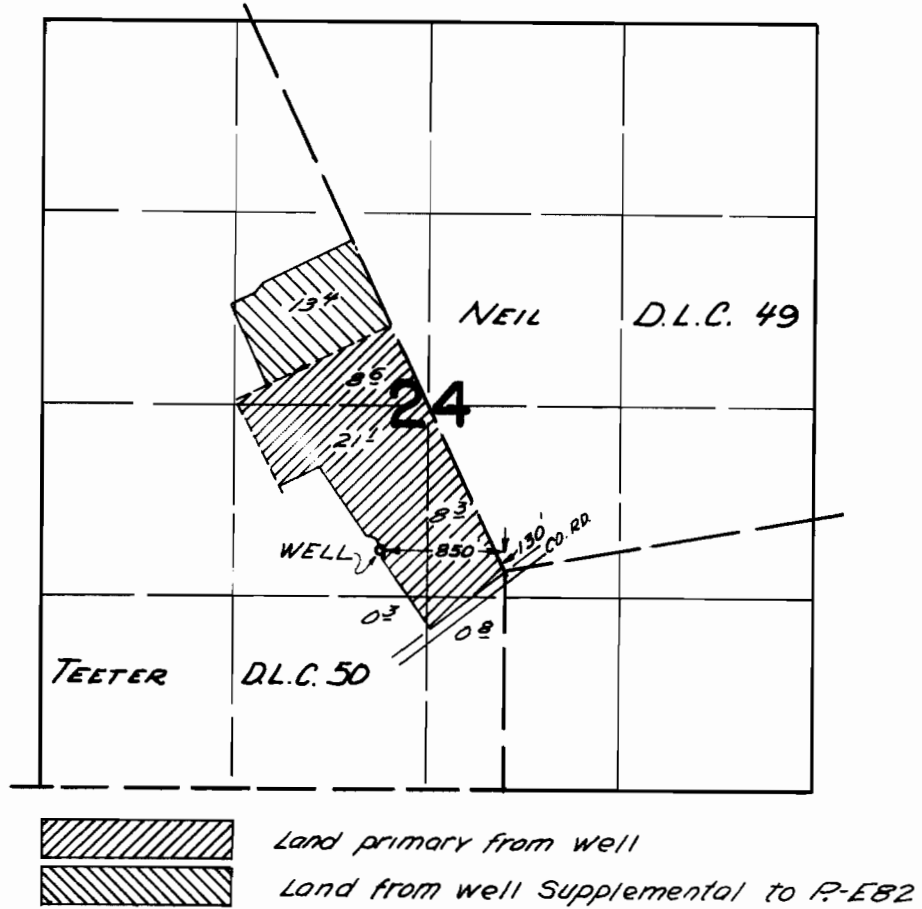

FINAL PROOF SURVEY UNDER

Application No. *G-2533*. Permit No. *G-2346*
IN NAME OF

BOYD L. HILTON

Surveyed *July 1, 1968*, by *V. Garner*