


T.7S.R.5W.W.M.

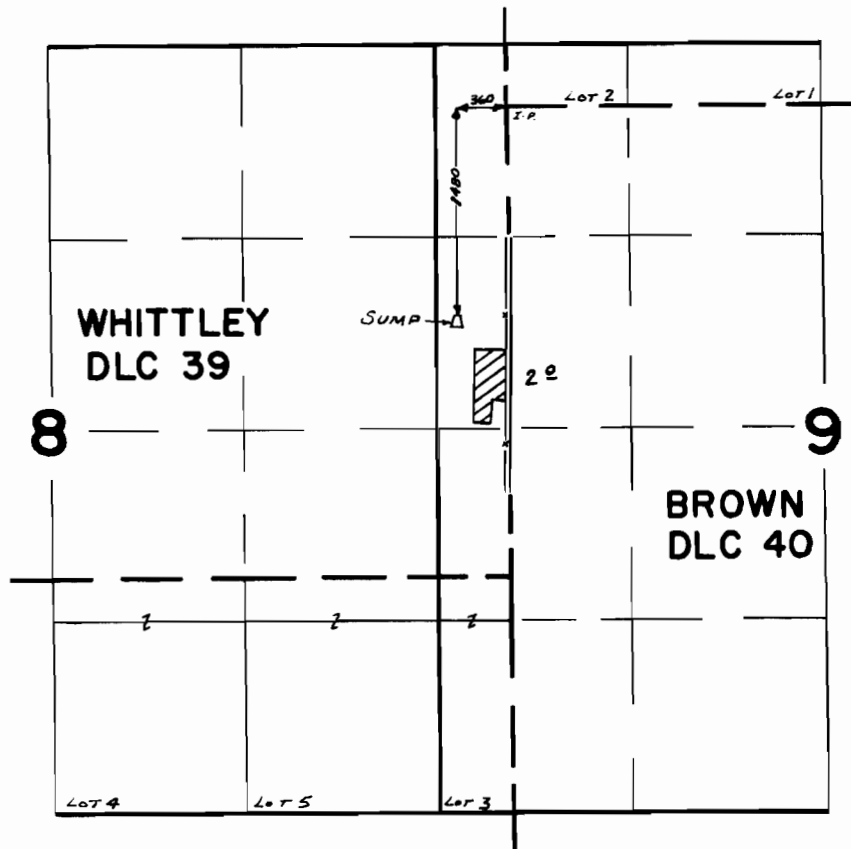

FINAL PROOF SURVEY
UNDER

Application No. G-3876 Permit No. G-3349
IN NAME OF

A. O. RUPP

Surveyed APR. 21. 1969, by D. BUELL