


T.7S.R.5W.W.M.

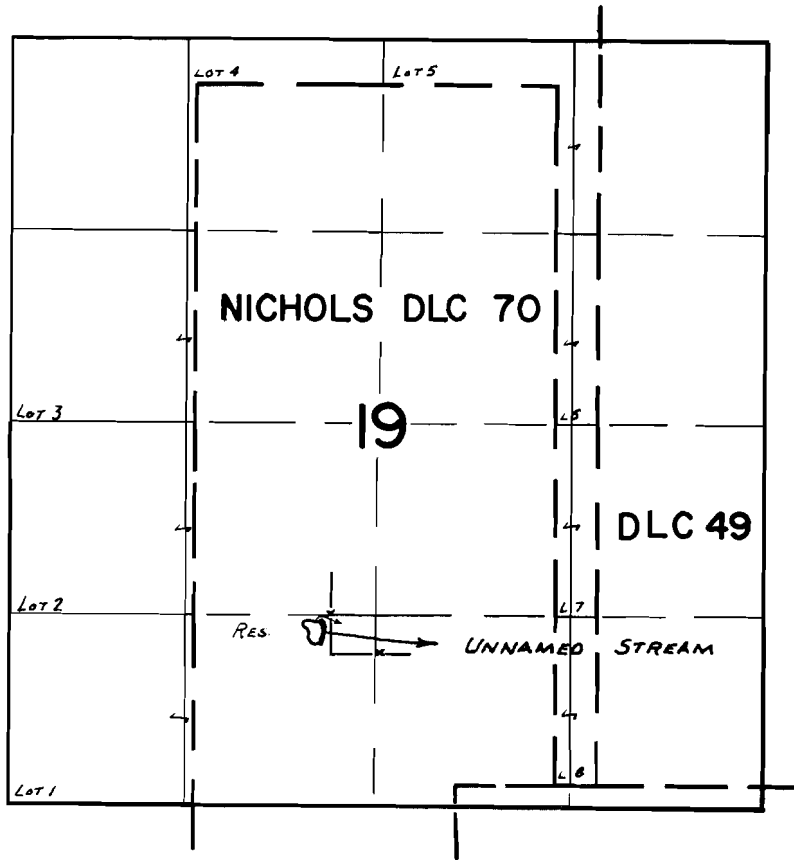

FINAL PROOF SURVEY
UNDER

Application No. *R-43099* Permit No. *R-4914*
IN NAME OF

HUBERT STAMY

Surveyed *APR. 11 1969*, by *D. BUELL*