


T.9S.R.5W.W.M.

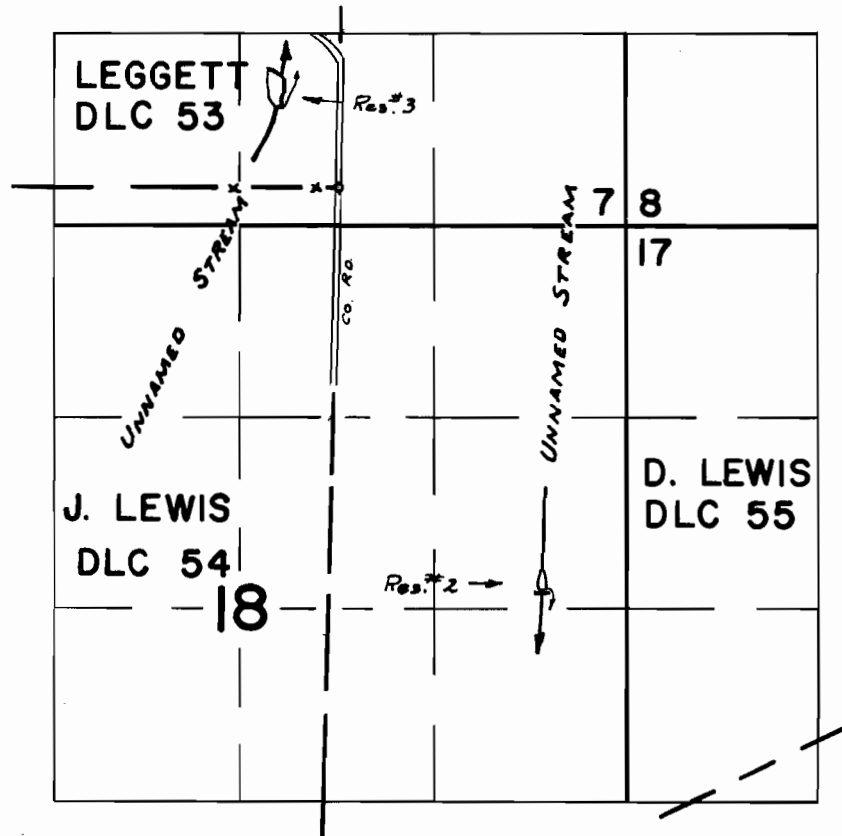

FINAL PROOF SURVEY UNDER

Application No. *R-43447* Permit No. *R-4996*
IN NAME OF

W. S. MCGUIRE

Surveyed *Apr. 8, 1969*, by *D. BUELL*