


T. 7 S. R. 5 W. W.M.

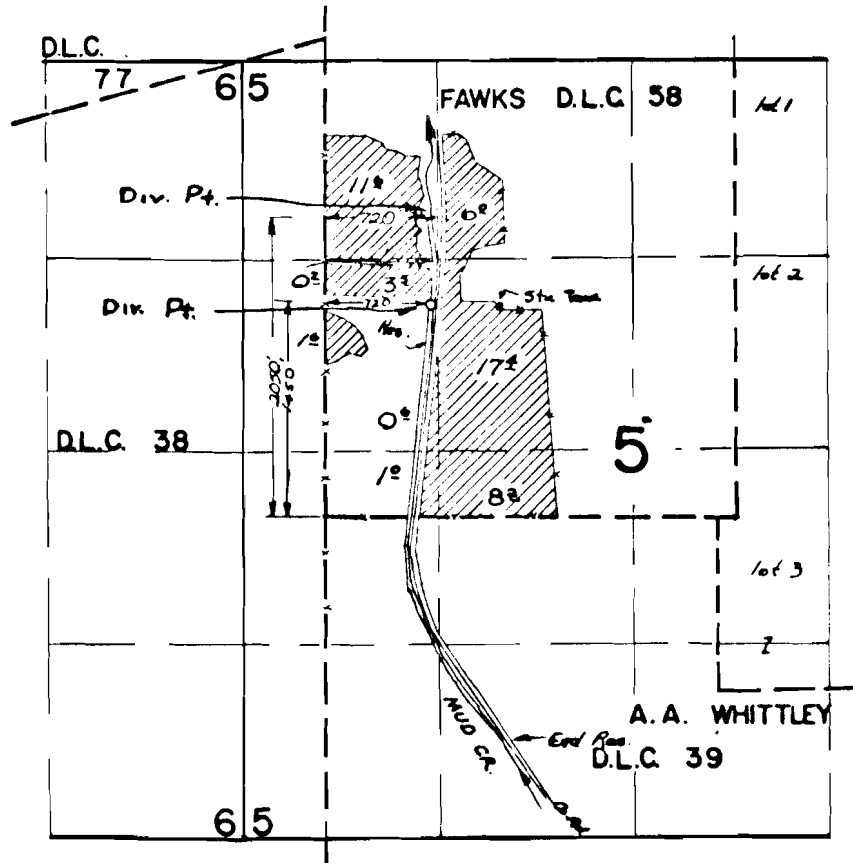

FINAL PROOF SURVEY UNDER

R 42281 R 4714
 42282 31205
 Application No. 41067 Permit No. 30436
 IN NAME OF

FRANK HOEKSTRE

Surveyed 23 JULY 1969, by D. R. BUELL