


# T. 7 S. R. 5 W. W.M.

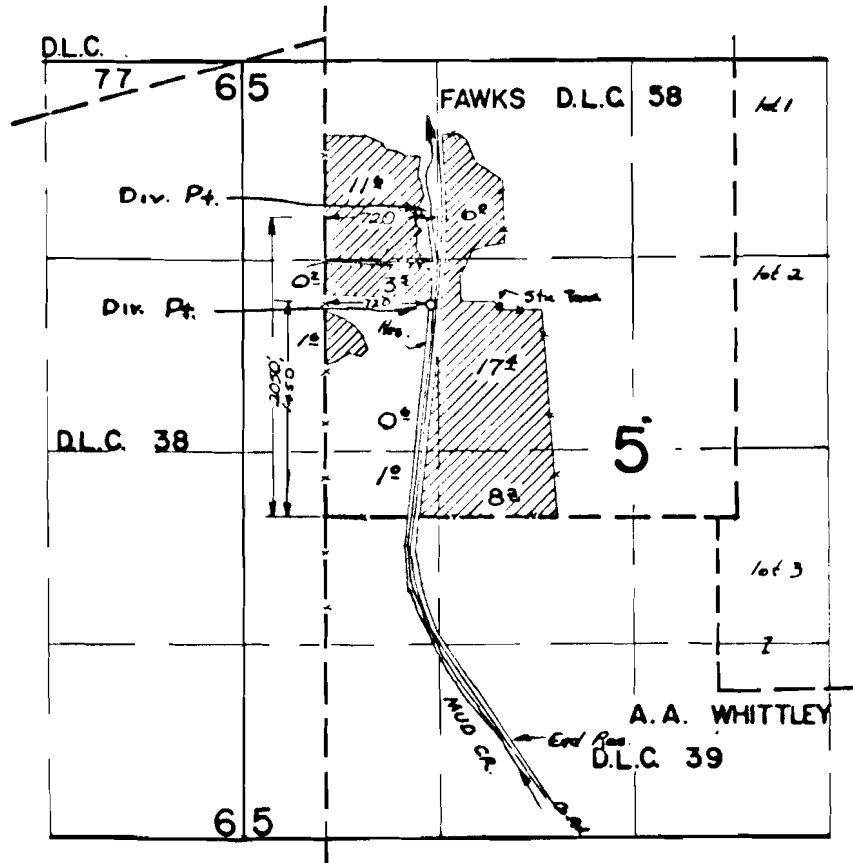

## FINAL PROOF SURVEY UNDER

R 42281                      R 4714  
 42282                      31205  
 Application No. 41067    Permit No. 30436  
 IN NAME OF

FRANK HOEKSTRE

Surveyed 23 JULY 1969, by D. R. BUELL