


# T.9S.R.6W.W.M.

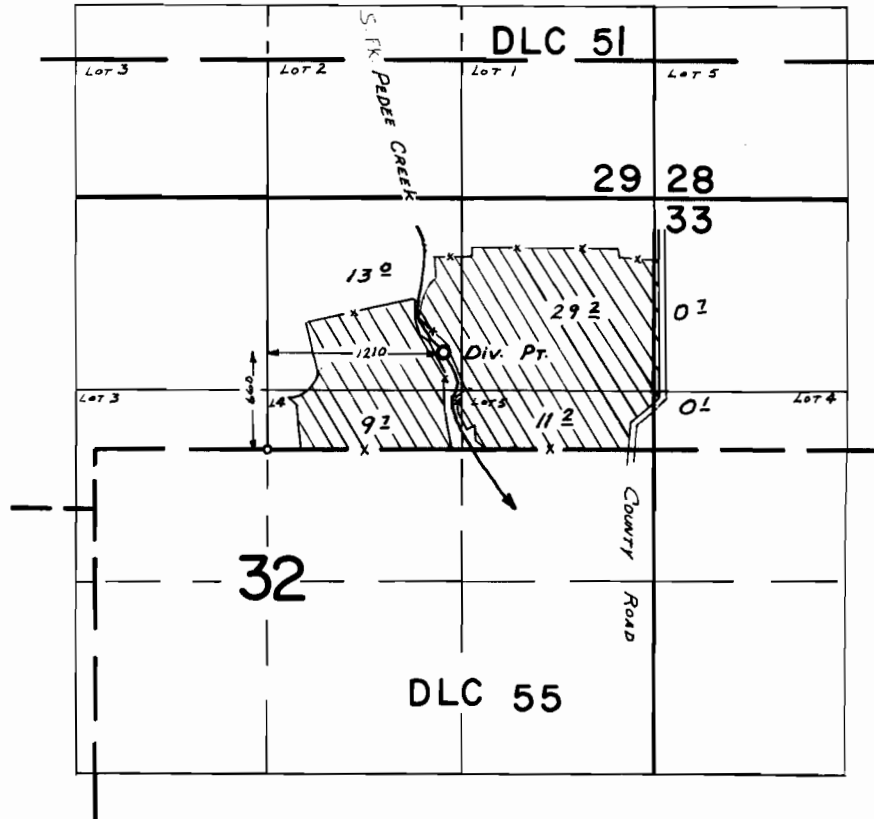

## FINAL PROOF SURVEY UNDER

Application No. 39415 Permit No. 29373  
IN NAME OF

**COMFORT CONDRON**

Surveyed APR. 10 1969, by D. BUELL