


T.6S.R.7W.W.M.

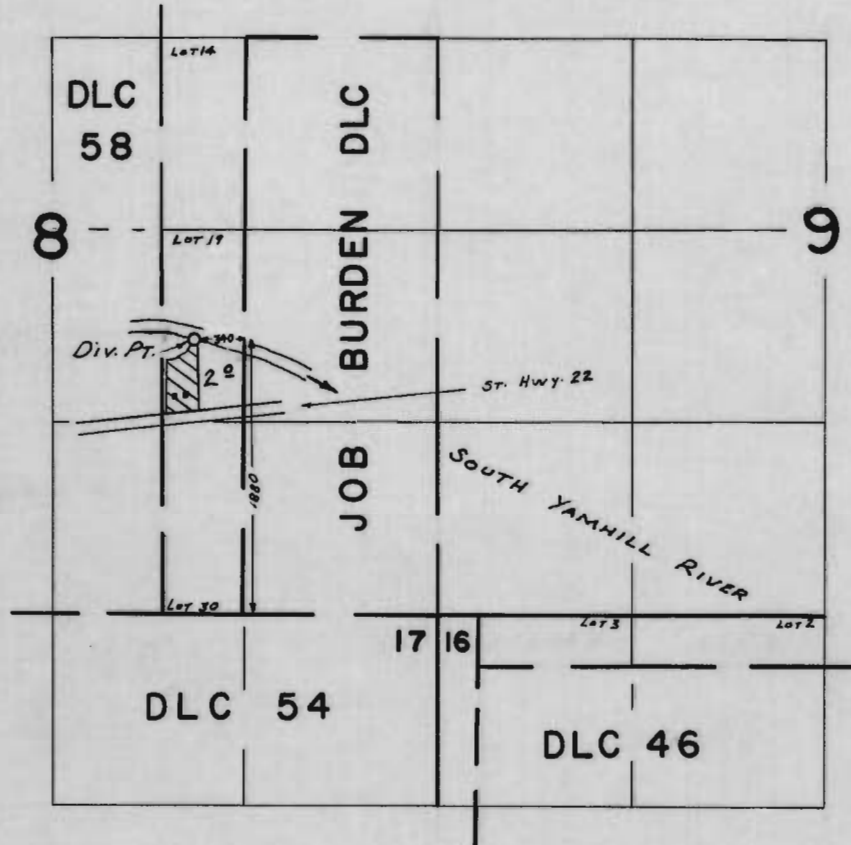

**FINAL PROOF SURVEY**  
UNDER

Application No. 42129 Permit No. 31510  
IN NAME OF

**ROY TUCKER**

Surveyed Nov. 17 1969, by D. BUELL