


T.8S.R.5W.W.M.

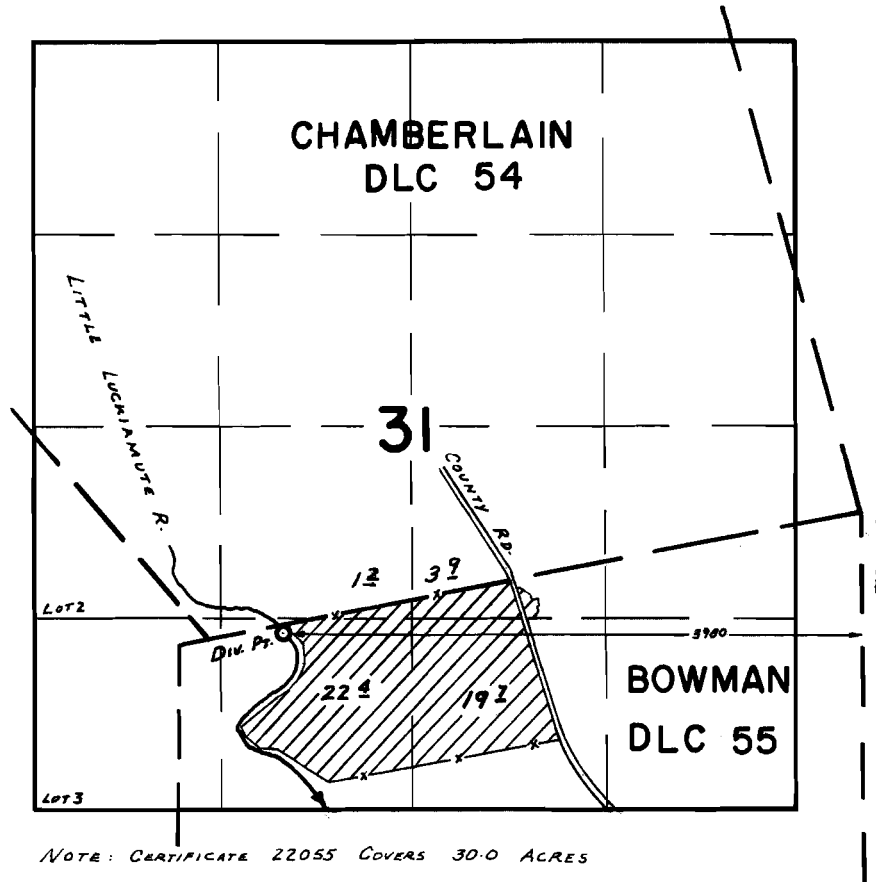

FINAL PROOF SURVEY
UNDER

Application No. 44598 Permit No. 33379
IN NAME OF

EDWARD L. WALTON

Surveyed APR. 10 1969, by D. Buell