


T. 3 S. R. 39 E. W.M.

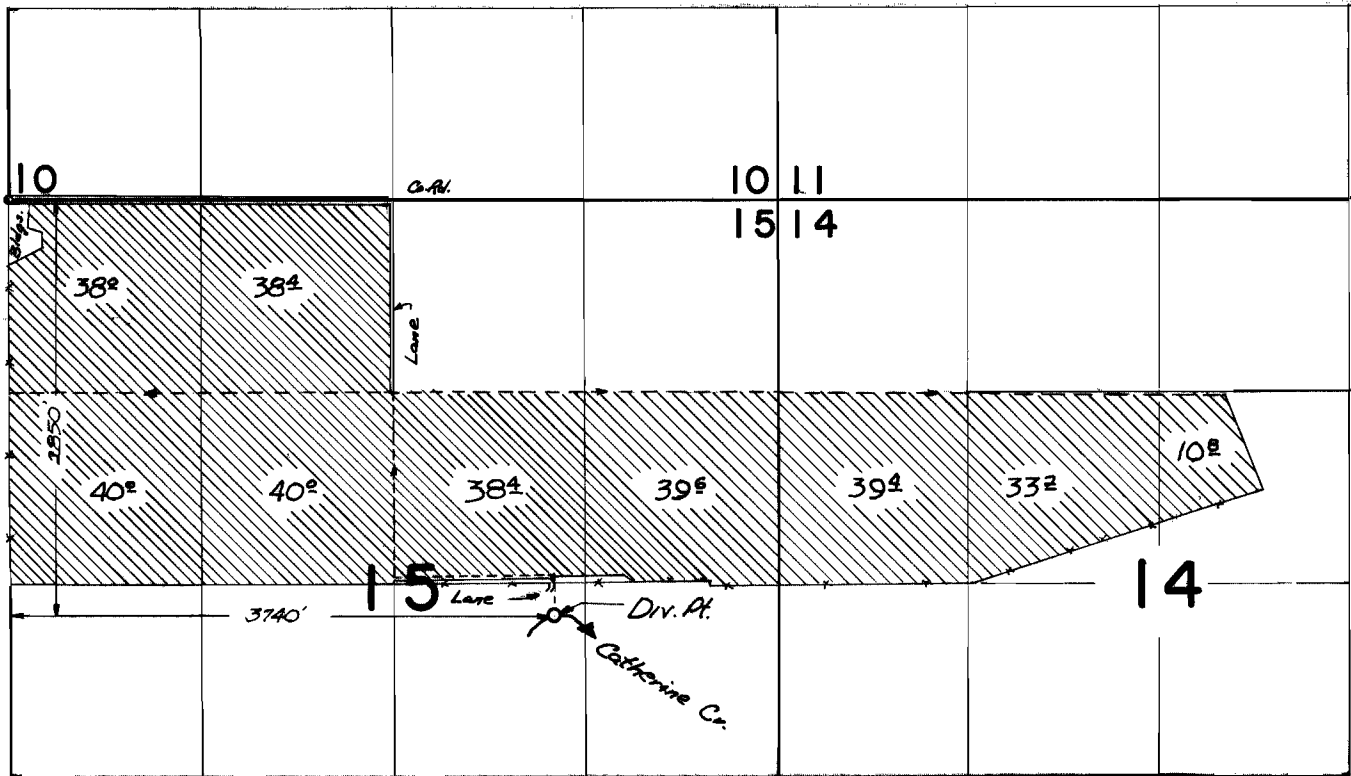

FINAL PROOF SURVEY UNDER

Application No. 39042 Permit No. 29075
IN NAME OF

ROBERT L. BIRD

Surveyed 22 AUG. 1969, by W. J. RUPPERT.