


T. 3 S. R. 40 E. W.M.

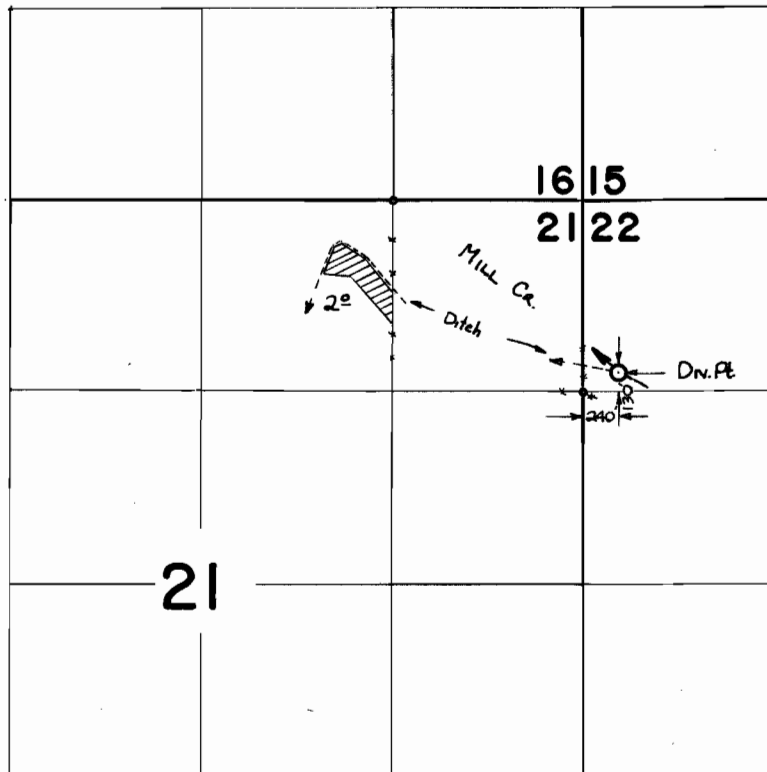

FINAL PROOF SURVEY UNDER

Application No. 40975 ... Permit No. 30556 ...
IN NAME OF

EVERETT W. & LILLIAN ADAMS

Surveyed 21 AUG. 1969, by W.J. RUPPERT