


Per. No. G-3393
Appl. G-3607

T.1N.R.12E.W.M.

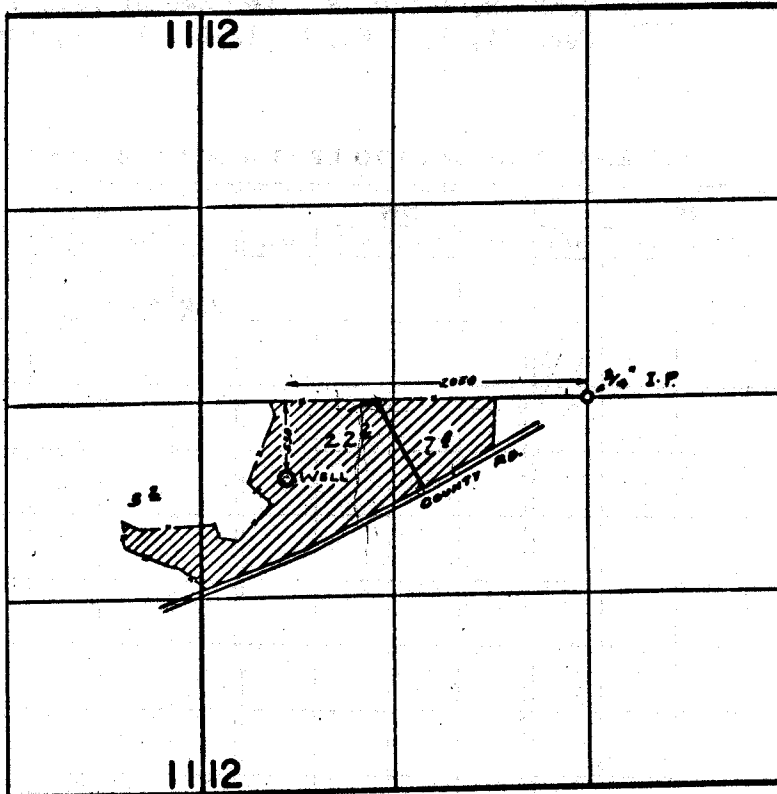

312
896
1208

FINAL PROOF SURVEY UNDER

Application No. G-3607 Permit No. G-3393
IN NAME OF

CLIFFORD S. & MAE A. TRYGG

Surveyed Nov. 6, 1969, by D. BULL