


Per. NO 33261
Appl. 44470

T.2N.R.14E.W.M.

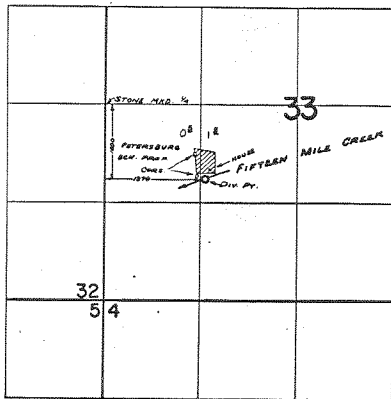

FINAL PROOF SURVEY
UNDER

Application No. 44470 Permit No. 33261
IN NAME OF

GARD & MAXINE FULTON

Surveyed Nov. 5, 1969, by D. BUELL