


T.1N. R.3W. W.M.

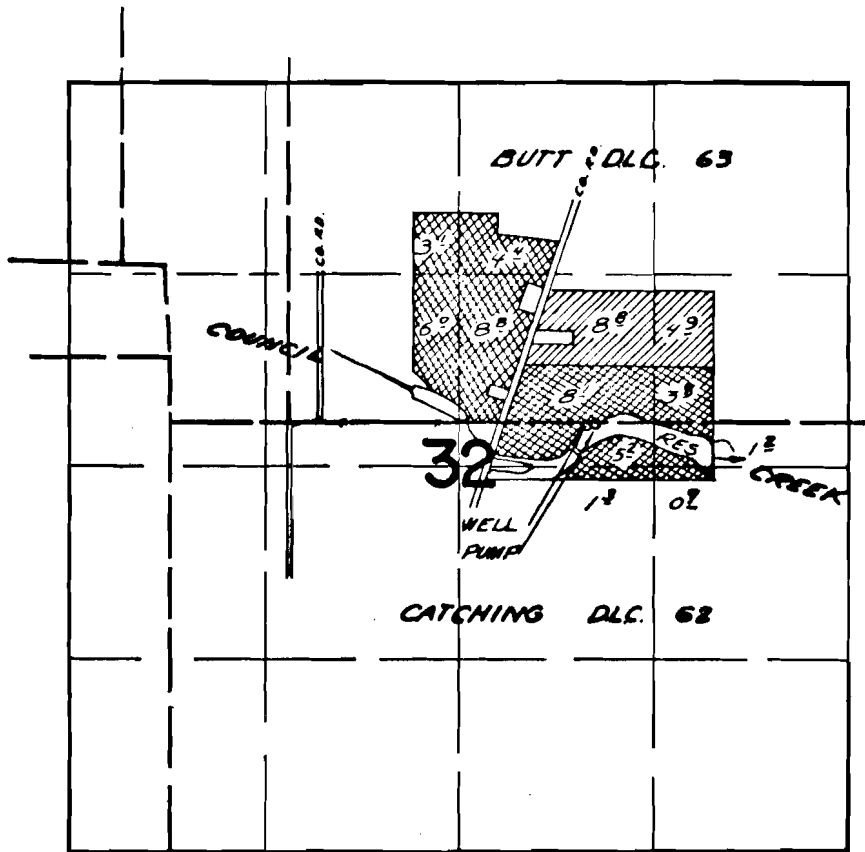

RESERVOIR DIV. PT LOCATED 2860 FT. E. & 230 FT. S.; WELL
 LOCATED 2020 FT. E. & 20 FT. S. BOTH FROM THE S.W.
 CORNER OF BUTT DLC. 63

FINAL PROOF SURVEY UNDER

R-38921
 38974
 R-40274
 40275

R-3687
 29039
 R-4500
 30024



Application No. G-2965 ... Permit No. G 2757
 IN NAME OF

HERBERT B. SAHNOW

Surveyed June 26 1968, by V. Garner.....