


T.9&10S. R.40E.W.M.

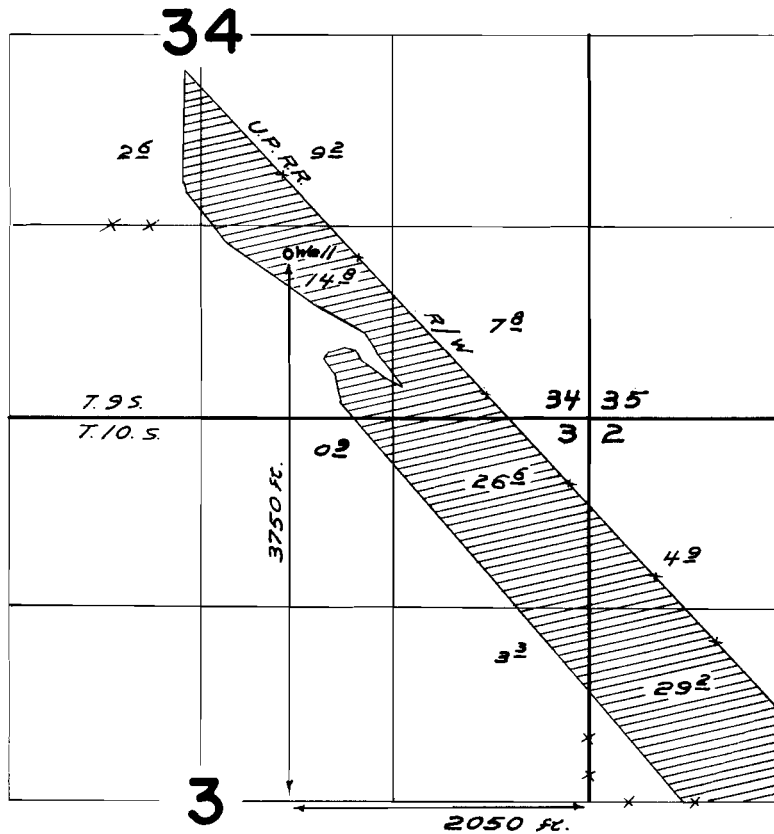

FINAL PROOF SURVEY UNDER

Application No. G-2804 Permit No. G-2609
IN NAME OF

George W. Logan

Surveyed Aug 11 1956, by W. J. Ruppert