


# T. 10 S. R. 4 W. W. M.

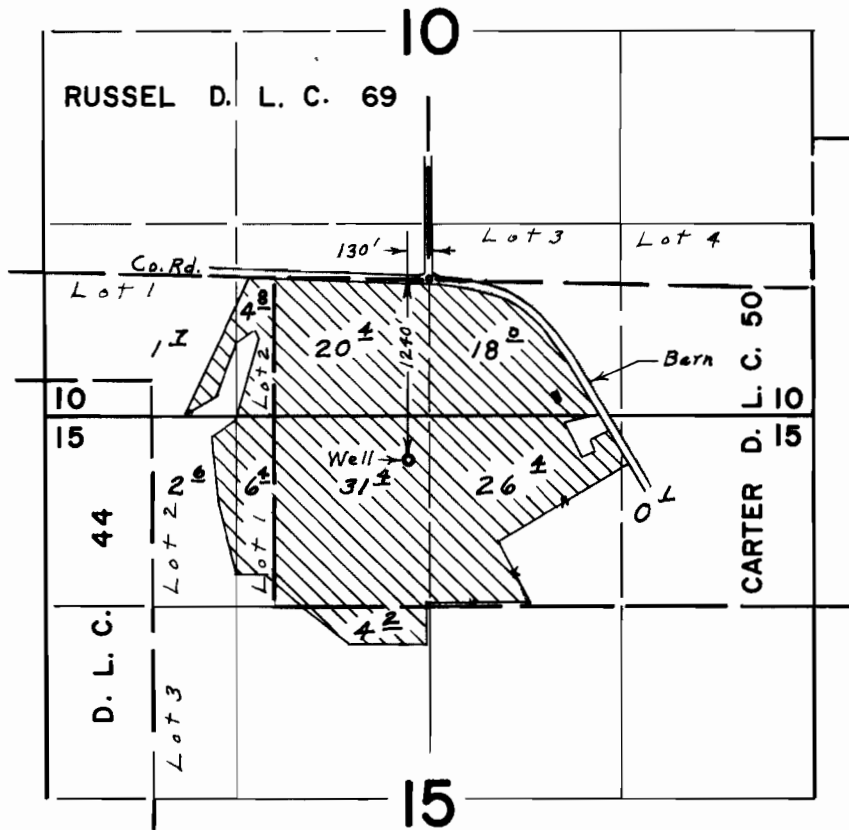

## FINAL PROOF SURVEY UNDER

Application No. G-2747 Permit No. G-2552  
IN NAME OF

**SAM J. WEESE**

Surveyed May 6, 1969, by L. E. Gould