


T. 12 S. R. 6 W. W. M.

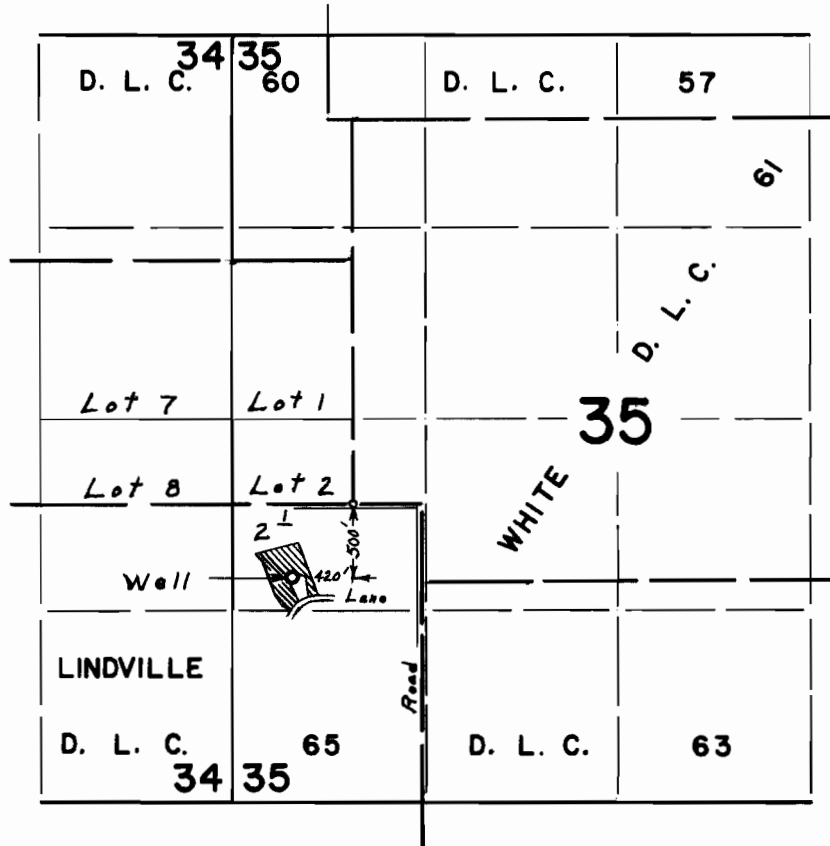

FINAL PROOF SURVEY UNDER

Application No. G-3179. Permit No. G-2988.
IN NAME OF

CARL A. SOLBERG

Surveyed June 18, 1969, by L. E. Gould