


TOWNSHIP 12S RANGE 5W W.M.

LOCATION OF WELL

Well No. 1-A N63°10'E 2427' from S.E. corner of Alfred Rhinehart D.L.C. No. 73

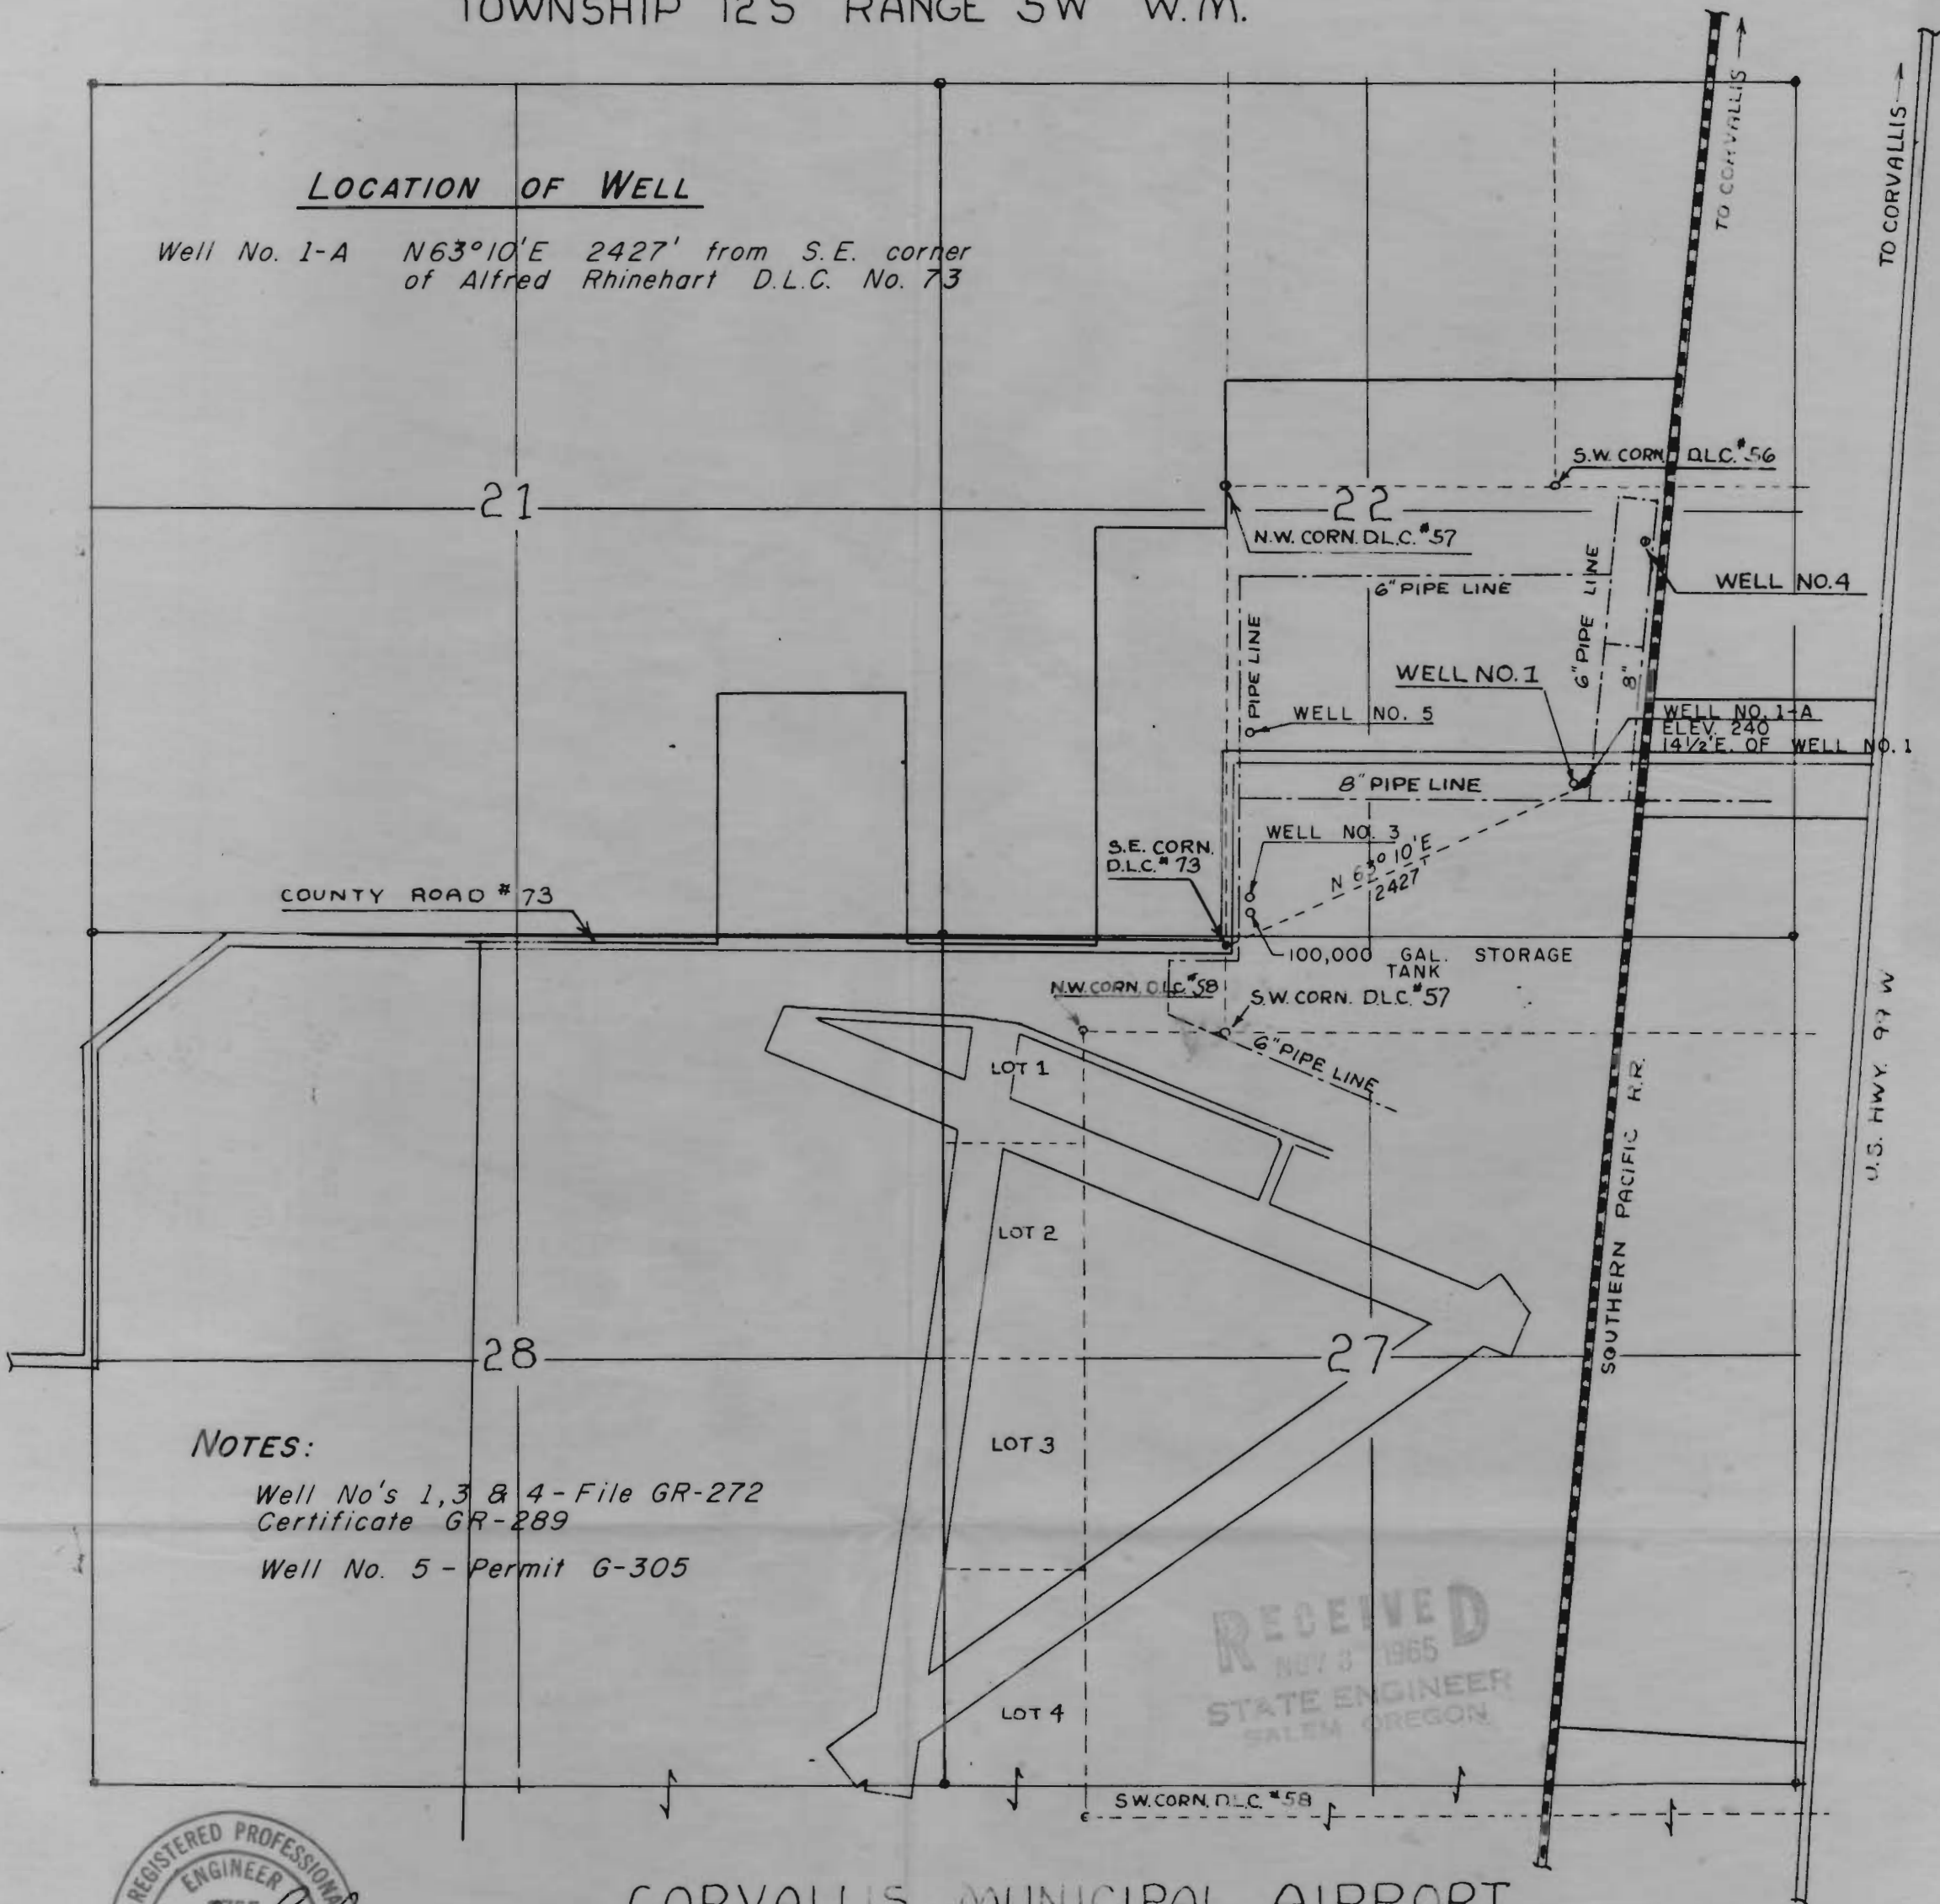

NOTES:

Well No's 1, 3 & 4 - File GR-272
Certificate GR-289

Well No. 5 - Permit G-305

RECEIVED
NOV 3 1965
STATE ENGINEER
SALEM OREGON



CORVALLIS MUNICIPAL AIRPORT
LOCATION OF WELLS FOR STATE REGISTRATION

SCALE = 1000' / INCH

Application No. G-3277
Permit No. G-3068