


T. 12 S. R. 6 W. W. M.

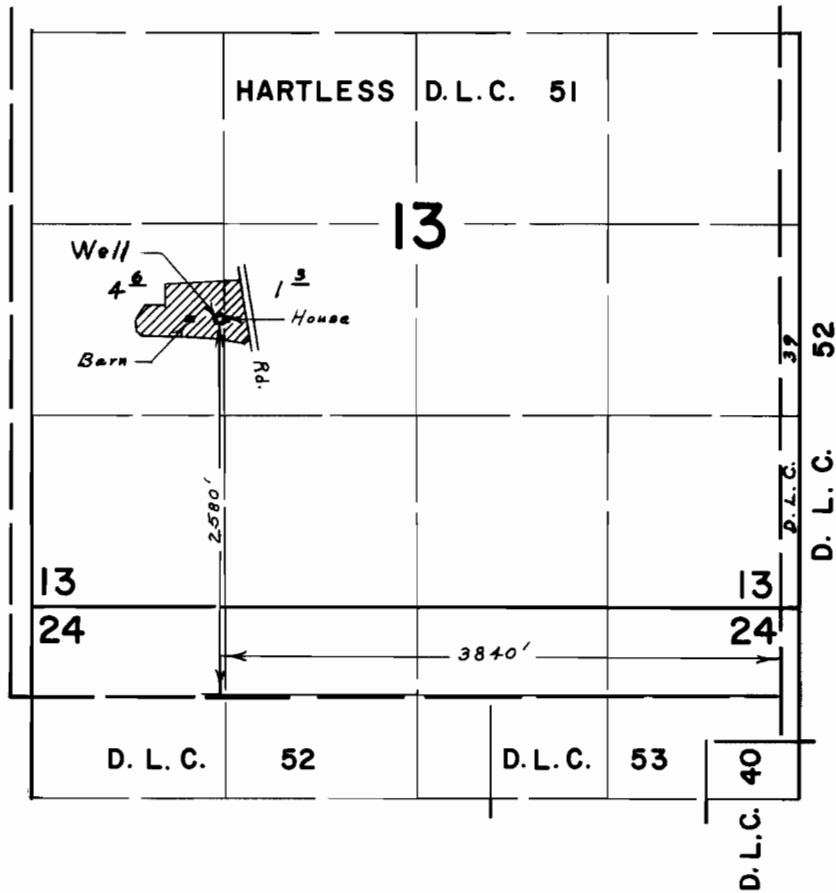

FINAL PROOF SURVEY UNDER

Application No. G-3564. Permit No. G-3098.
IN NAME OF

JAMES FESSLER

Surveyed June 30, 1969., by L. E. Gould