


T. 11 S. R. 4 & 5 W. W. M.

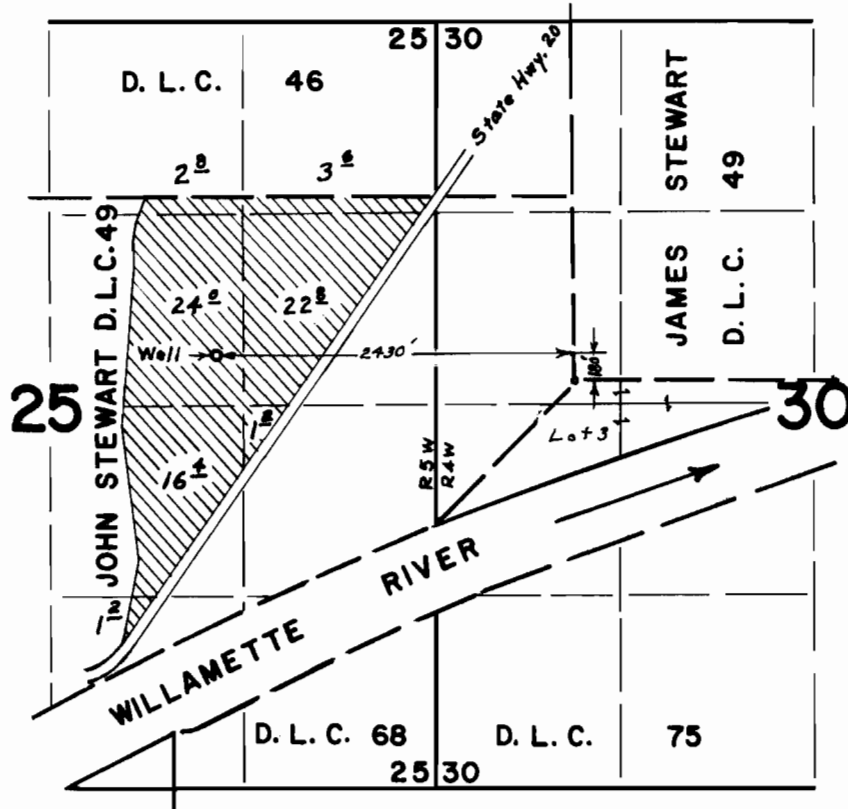

FINAL PROOF SURVEY UNDER

Application No. G-3890. Permit No. G-3657.
IN NAME OF

MARY M. GOLDBLATT & ARTHUR L. McFADDEN

Surveyed May 9, 1969, by L. E. Gould