

Mean elevation bottom 258.5'.
Average area 63 acres.
Acre feet 33.4.

Mean elevation bottom 257.8'.
Average area 13.8 acres.
Acre feet 55.2.

OPEN DITCH FOR NATURAL DRAINAGE OF AREA

S. 1/4 Cor. Sec. 12
N. 1/4 Cor. Sec. 13

Hub No. 1

Sawmill


Waste Spillway constructed from 2x12 - Controlled by 2% crosswise in channel

4" Pipe from well to pond. (22' N 61/2' E from SE Cor. D. Henderson) D.L.C. #46

LES HOBIN LOG POND PHILOMATH, ORE.


Sec. 12 & 13, T. 12 S., R. 6 W., W. M.
Scale 1" = 50' Bert W. Udell
March 20, 1957 Reg. Engr. #2301

TYPICAL DIKE CROSS SECTION

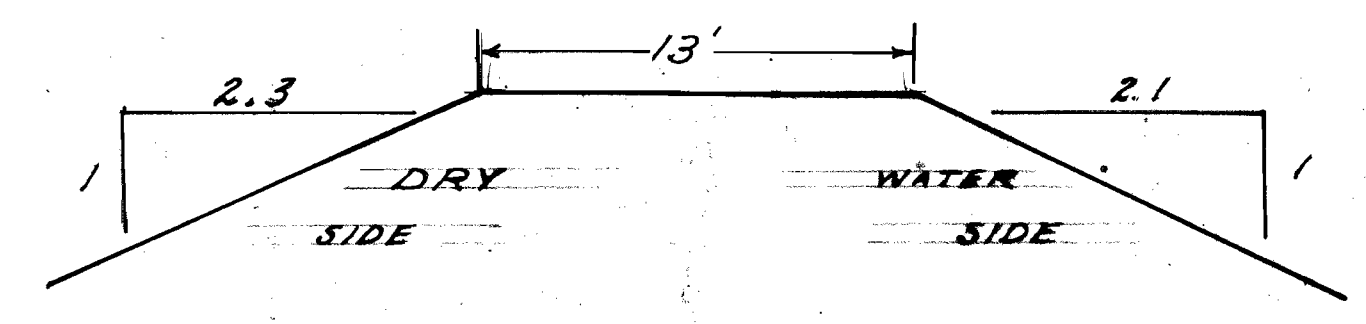

David Henderson C.I. 46 Henry Penland C.I. 45
3-45-A

Application No. G-630, R-39967, 39968
Permit No. G-540, R-3976, 29080

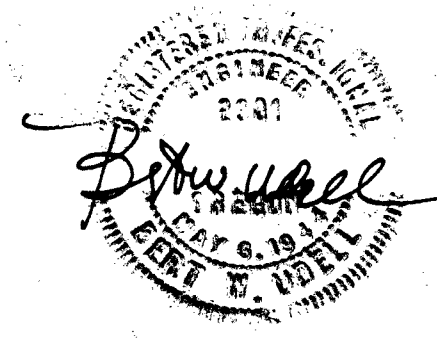

RECEIVED
APR 26 1957
STATE ENGINEER