


T. 10 S. R. 4 W. W.M.

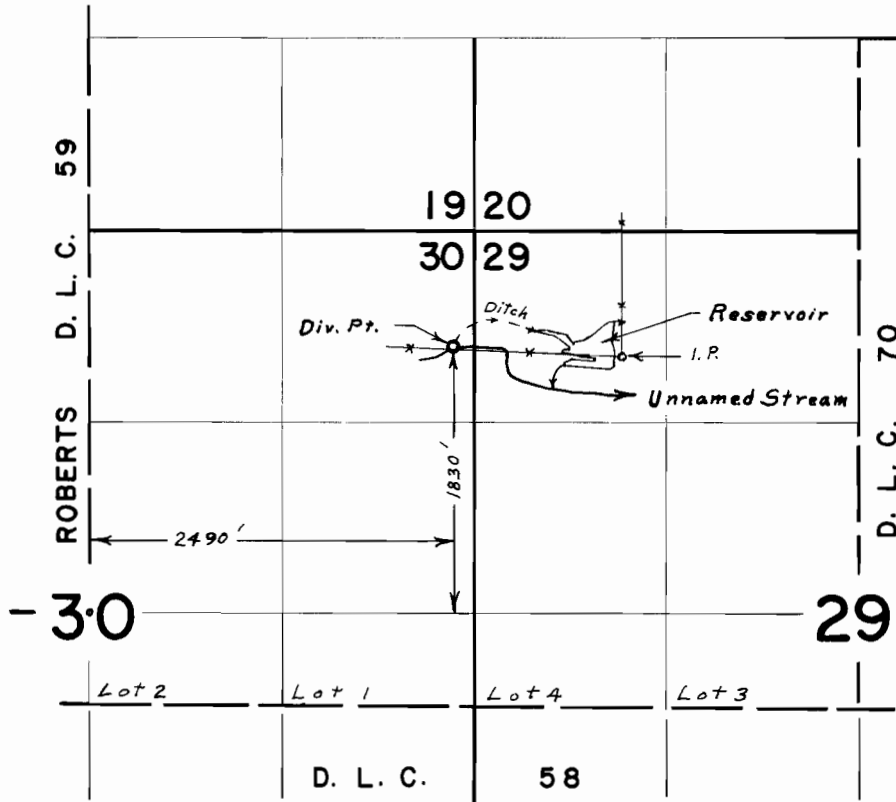

FINAL PROOF SURVEY UNDER

R-42299 R-4817
 Application No. 42300 Permit No. 31717
 IN NAME OF

RUBEN SMITH

Surveyed May 7, 1969, by L. E. Gould