


# T. 11 S. R. 7 W. W. M.

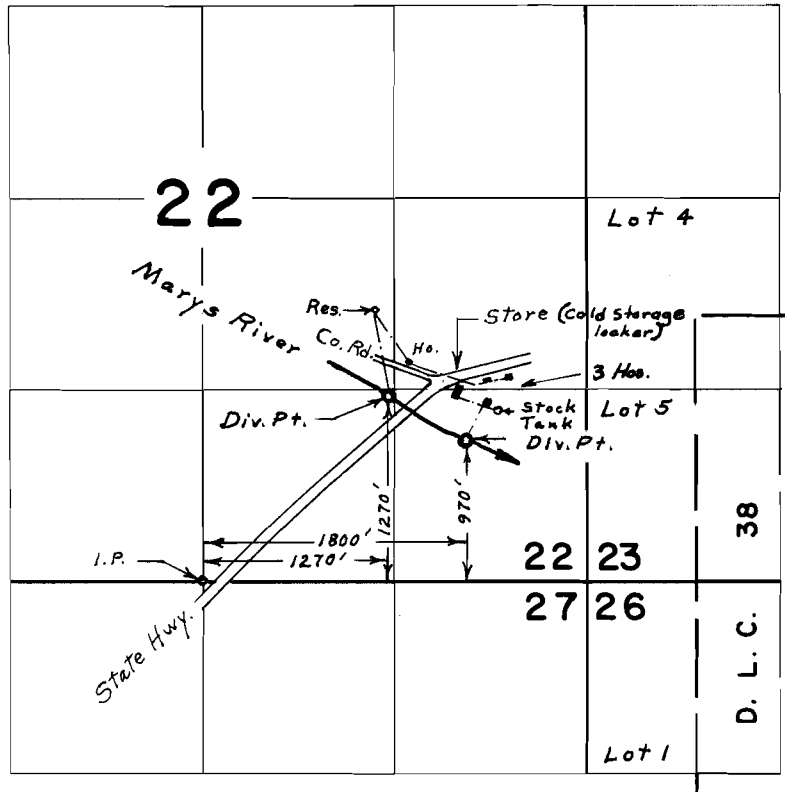

## FINAL PROOF SURVEY UNDER

Application No. 4.0038 Permit No. 29846  
IN NAME OF

FLOYD F. VOSBERG

Surveyed Sept. 3, 1969, by L. E. Gould