


T. 11 S. R. 6 W. W. M.

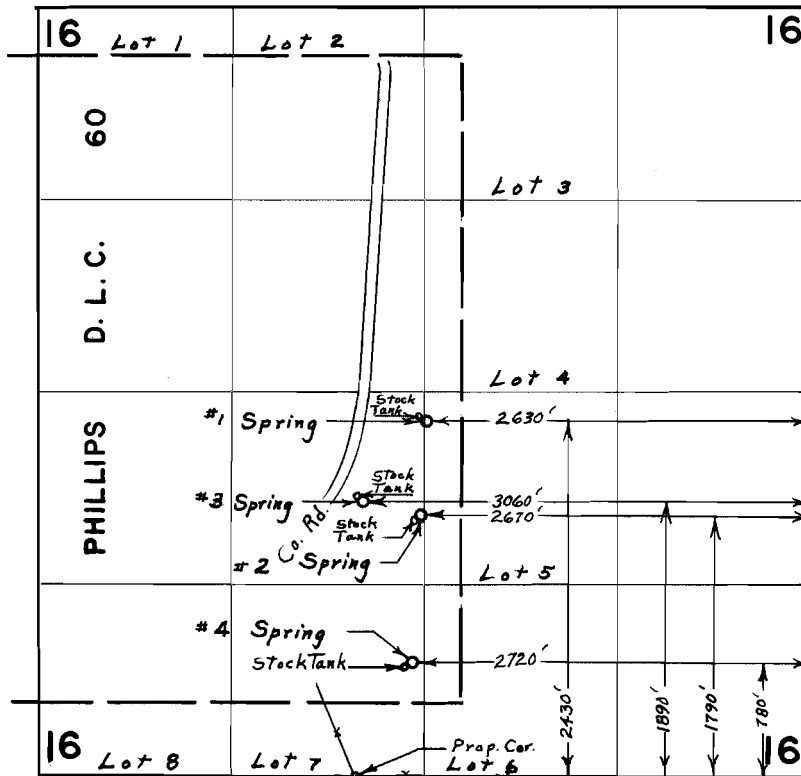

FINAL PROOF SURVEY
UNDER

Application No. 44229 Permit No. 33038
IN NAME OF

GEORGE S. & EDNA L. McDOWELL

Surveyed Aug. 13, 1969, by L. E. Gould