


# T. 10 S. R. 6 W. W. M.

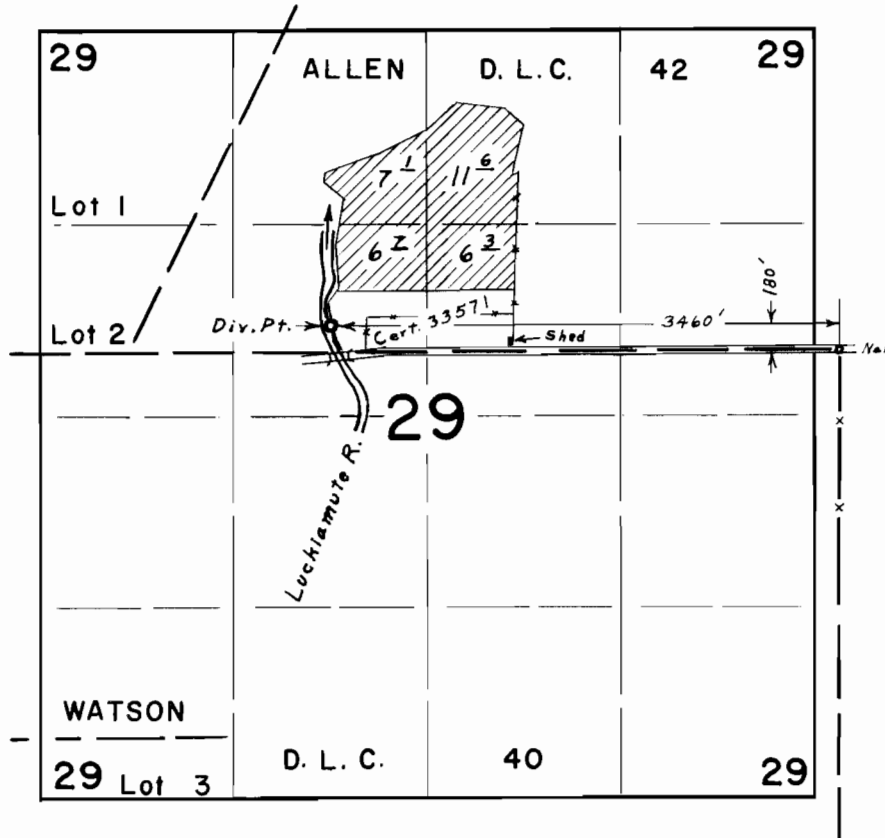

## FINAL PROOF SURVEY UNDER

Application No. 41116 ... Permit No. 30654  
IN NAME OF

**GRACEN L. BUSH**

Surveyed May 9, 1969, by L. E. Gould