


T.13S.R.7W.W.M.

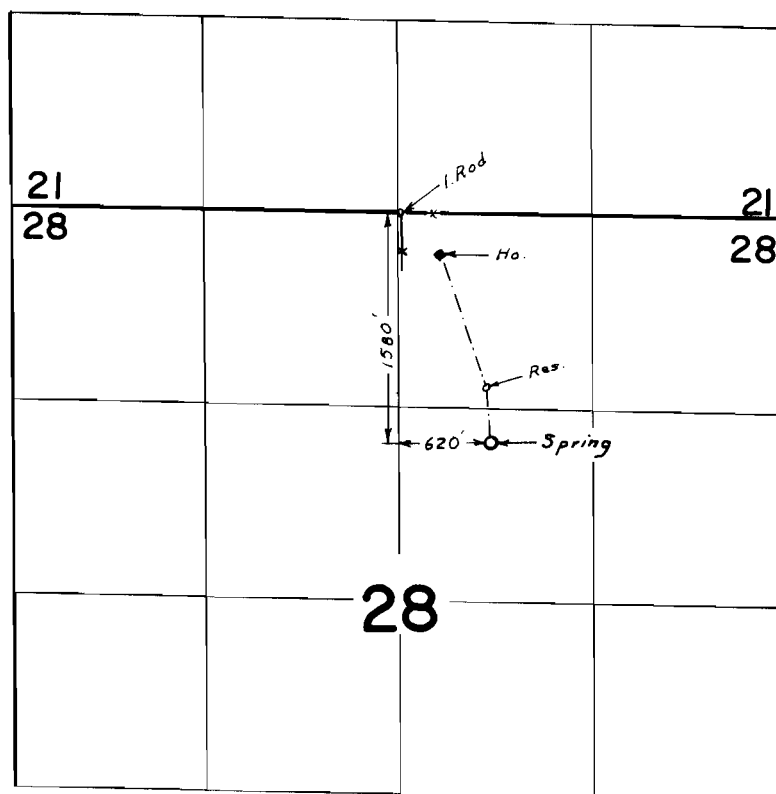

FINAL PROOF SURVEY
UNDER

Application No. 41965 Permit No. 31048
IN NAME OF

CAROLYN HUDMAN & CARLA CARPENTER

Surveyed Nov. 14 1969, by L. E. Gould