


T. 10 S. R. 6 W. W. M.

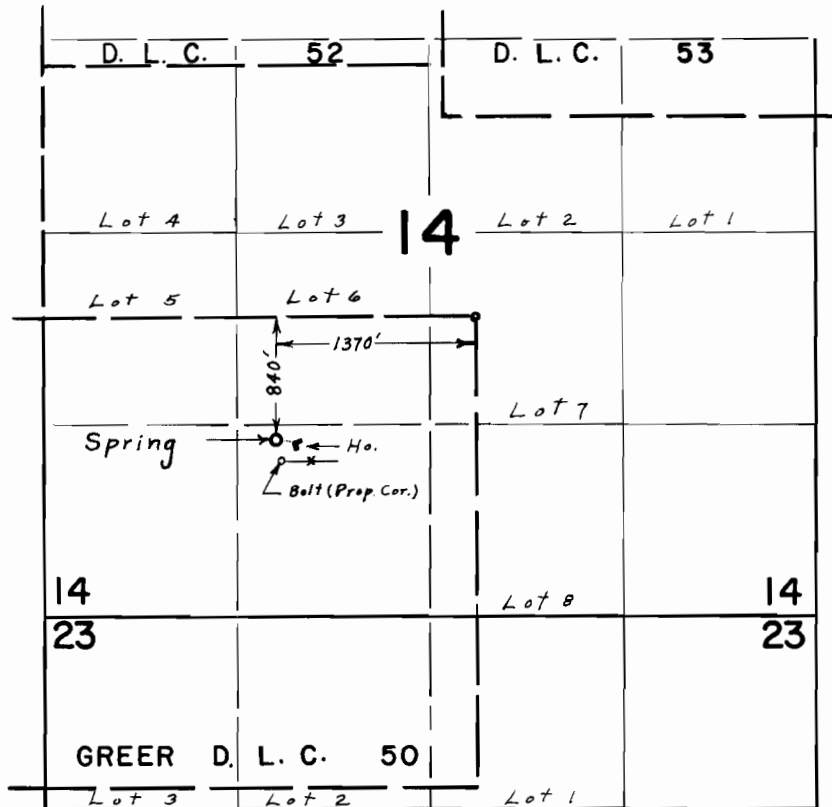

FINAL PROOF SURVEY UNDER

Application No. 41865 Permit No. 31324
IN NAME OF

GEORGE R. SPINNEY

Surveyed May, 8, 1969, by L. E. Gould