


T. 12 S. R. 6 W. W. M.

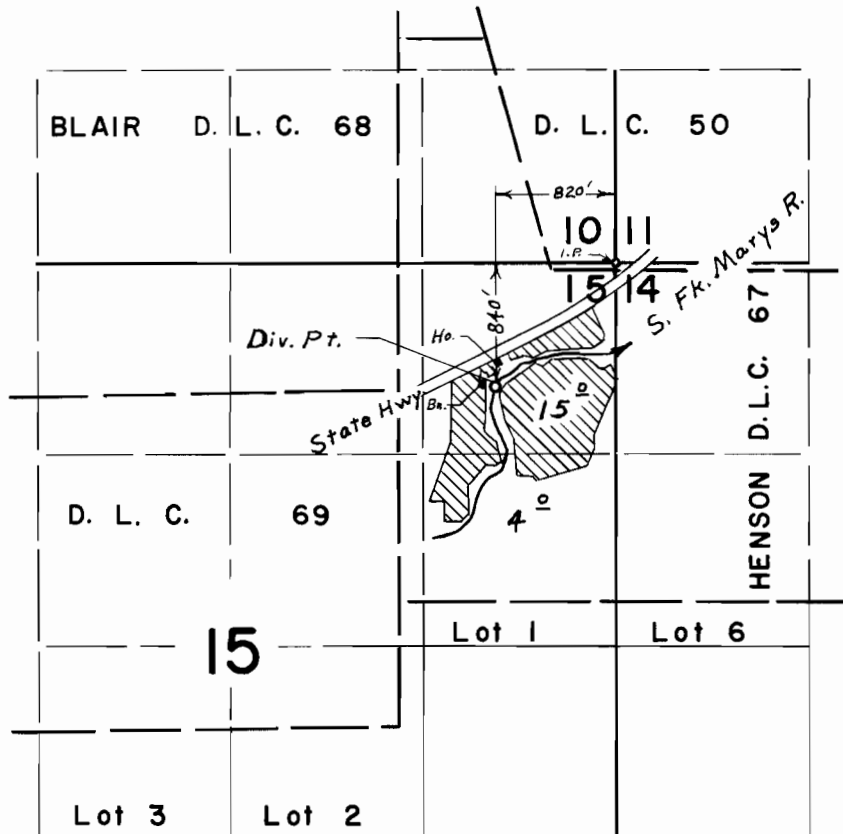

FINAL PROOF SURVEY UNDER

Application No. 43247 Permit No. 31929
IN NAME OF

LYNN & BLANCHE CLARK

Surveyed June 19, 1969, by L. E. Gould