


T. 11 S. R. 6 W. W. M.

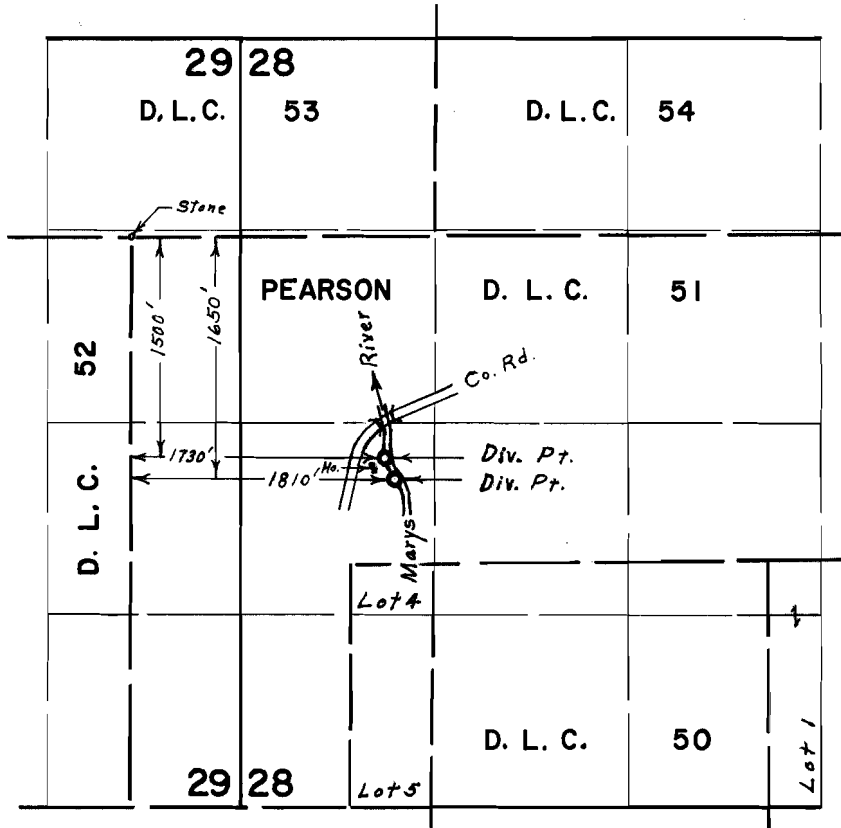

FINAL PROOF SURVEY UNDER

Application No. 44287 Permit No. 33078
IN NAME OF

JOHN D. STOKES

Surveyed Aug. 14, 1969, by L. E. Gould