


T.28 & 29S. R.12 & 13W. W.M.

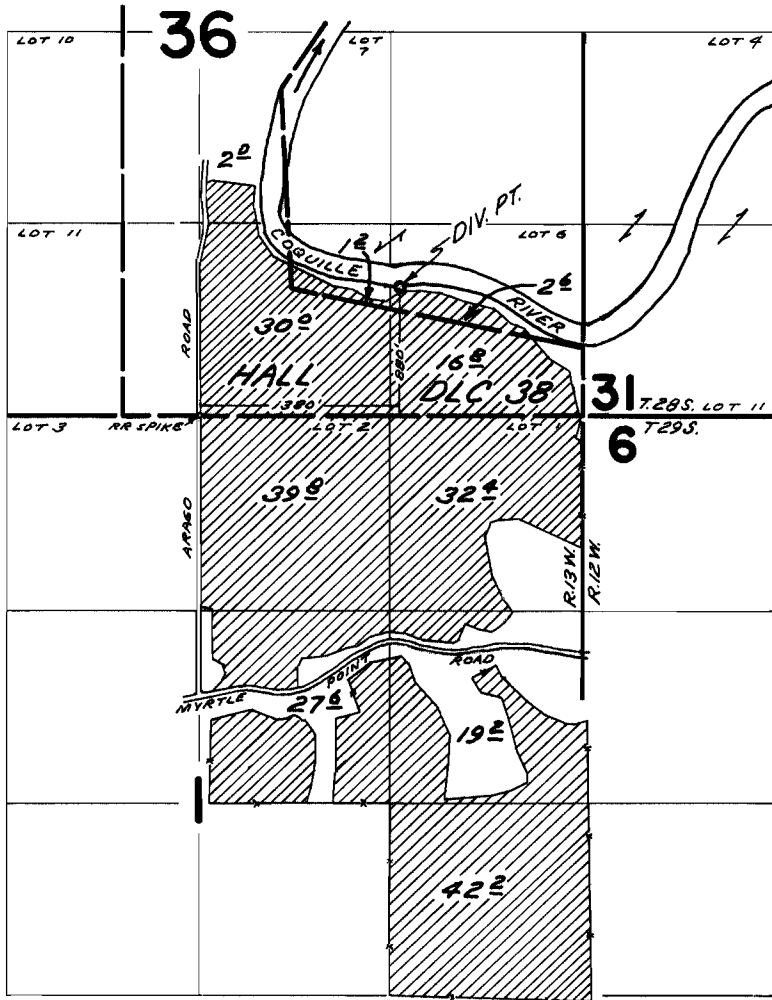

FINAL PROOF SURVEY UNDER

Application No. 37733 Permit No. 28128
IN NAME OF

RUSSELL TRAIN

Surveyed AUG. 28 1969, by D. BUELL