


# T. 29 S. R. 12 W. W.M.

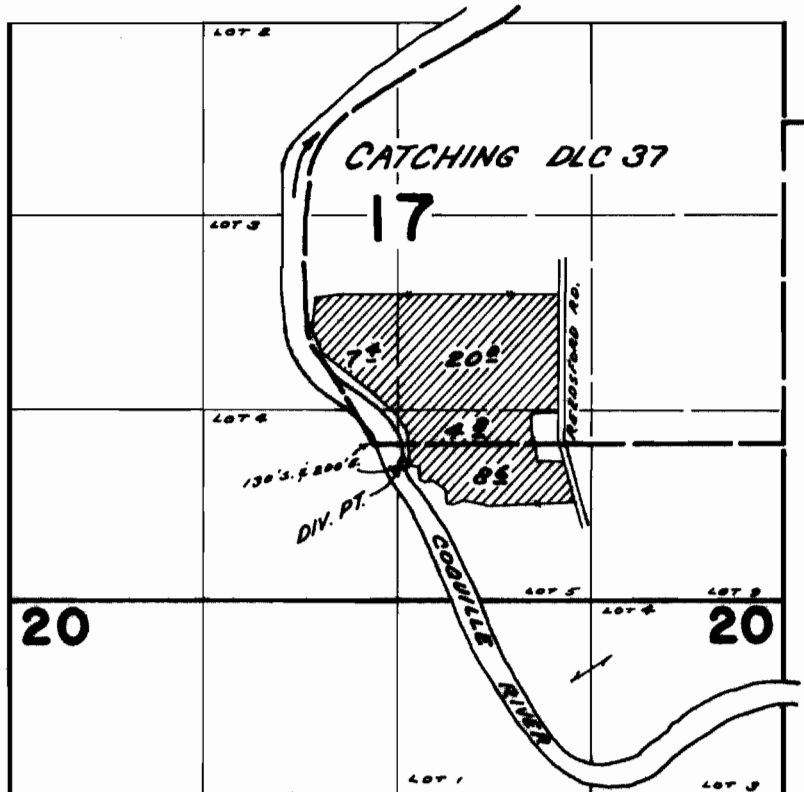

## FINAL PROOF SURVEY UNDER

Application No. 41212 Permit No. 30815  
IN NAME OF

TRAIN LOGGING CO., INC.

Surveyed AUG. 28 1969, by D. BUELL