T.28S.R.14W.W.M.

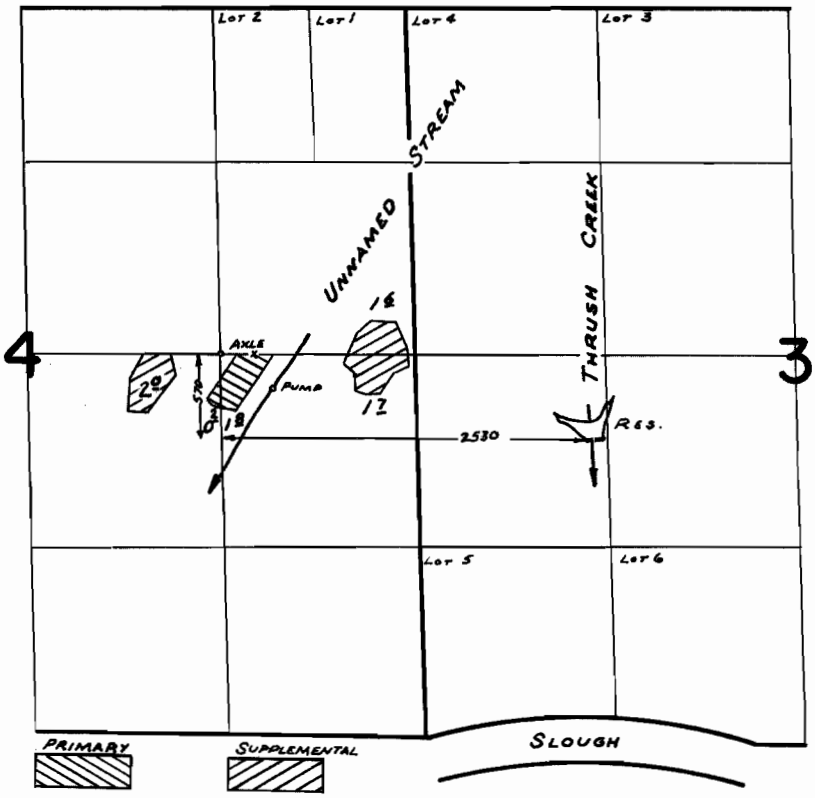

FINAL PROOF SURVEY
UNDER

Application No. 42311 Permit No. 31788
IN NAME OF
KATHLEEN N. RUDDELL &
THE ESTATE OF DELBERT C. RUDDELL

Surveyed May 14, 1969, by W. Ruppert

B.M.
1969-K