


T. 36 S. R. 14 W. W. M.

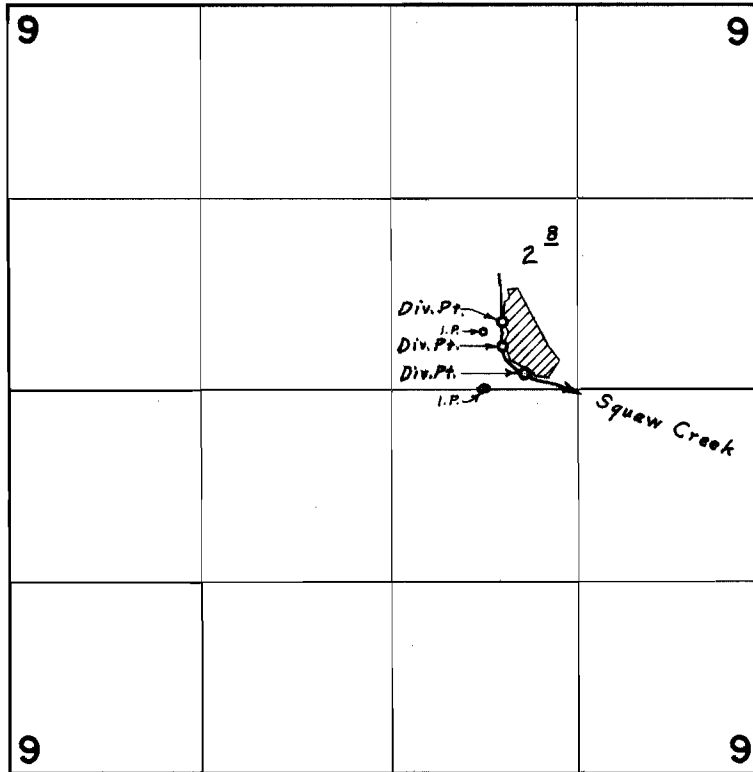

Div. Pts. located; 470' N. & 520' W., 290' N. & 520' W., 110' N. & 370' W., all from S.E. Corner S.W. & N.E. of Section 9

FINAL PROOF SURVEY UNDER

Application No. 39792 Permit No. 29579
IN NAME OF

WAYNE W. & GRACE E. MIDDLETON

Surveyed Aug. 22, 1969, by L. E. Gould