


T. 32 S. R. 15 W. W.M.

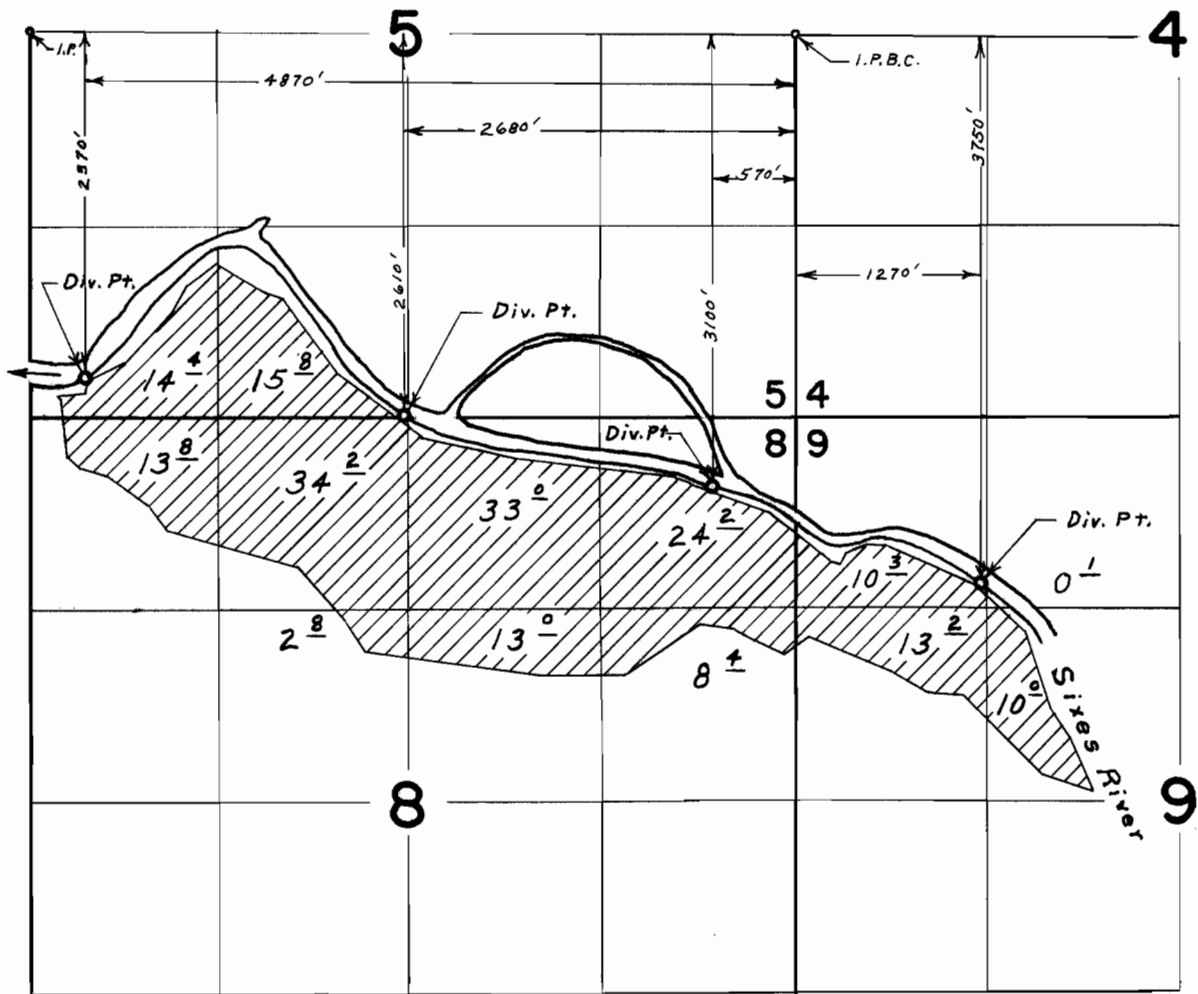

FINAL PROOF SURVEY UNDER

Application No. 39820 Permit No. 29649
IN NAME OF
A. W. SWEET

Surveyed May 14, 1969, by L. E. Gould